


HAROLD H. KOLB

REGISTERED PROFESSIONAL LAND SURVEYOR
LAKE GENEVA, WISCONSIN

LOCUST ROAD - 40' WIDE

HEMLOCK ROAD - 40' WIDE

WALNUT ROAD - 40' WIDE

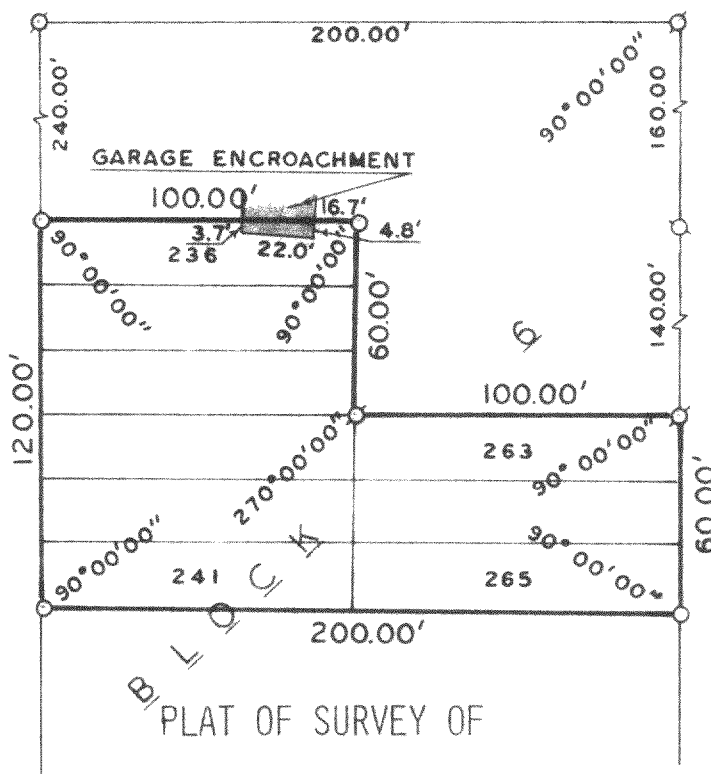

LOTS 236-241 AND LOTS 263-265, BLOCK 6,
SECTION 1, PELL LAKE SUBDIVISION, T1N,
R18E, WALWORTH COUNTY, WISCONSIN.

OWNER: JOHN K. KOSS

ACCURACY: DISTANCE 0.01'
ANGLES 05"
ERROR OF CLOSURE LESS THAN 1/3000

SCALE: 1" = 60'

LEGEND

- φ — IRON PIPE FOUND
- — IRON PIPE PLACED
- — CONCRETE MONUMENT
- x — SPIKE



I, HAROLD H. KOLB, DO HEREBY CERTIFY THAT I HAVE SURVEYED THE PROPERTY HEREON DESCRIBED ACCORDING TO THE OFFICIAL RECORDS, AND THAT THE PLAT HEREON IS A CORRECT REPRESENTATION OF THE LOT LINES.

HAROLD H. KOLB
WISCONSIN REGISTERED LAND SURVEYOR, S-187
DATE Nov 4, 1975