


DUNHAM SURVEYING, S.C.  
SURVEYING & SUBDIVIDING  
DELAVAN, WISCONSIN 53115

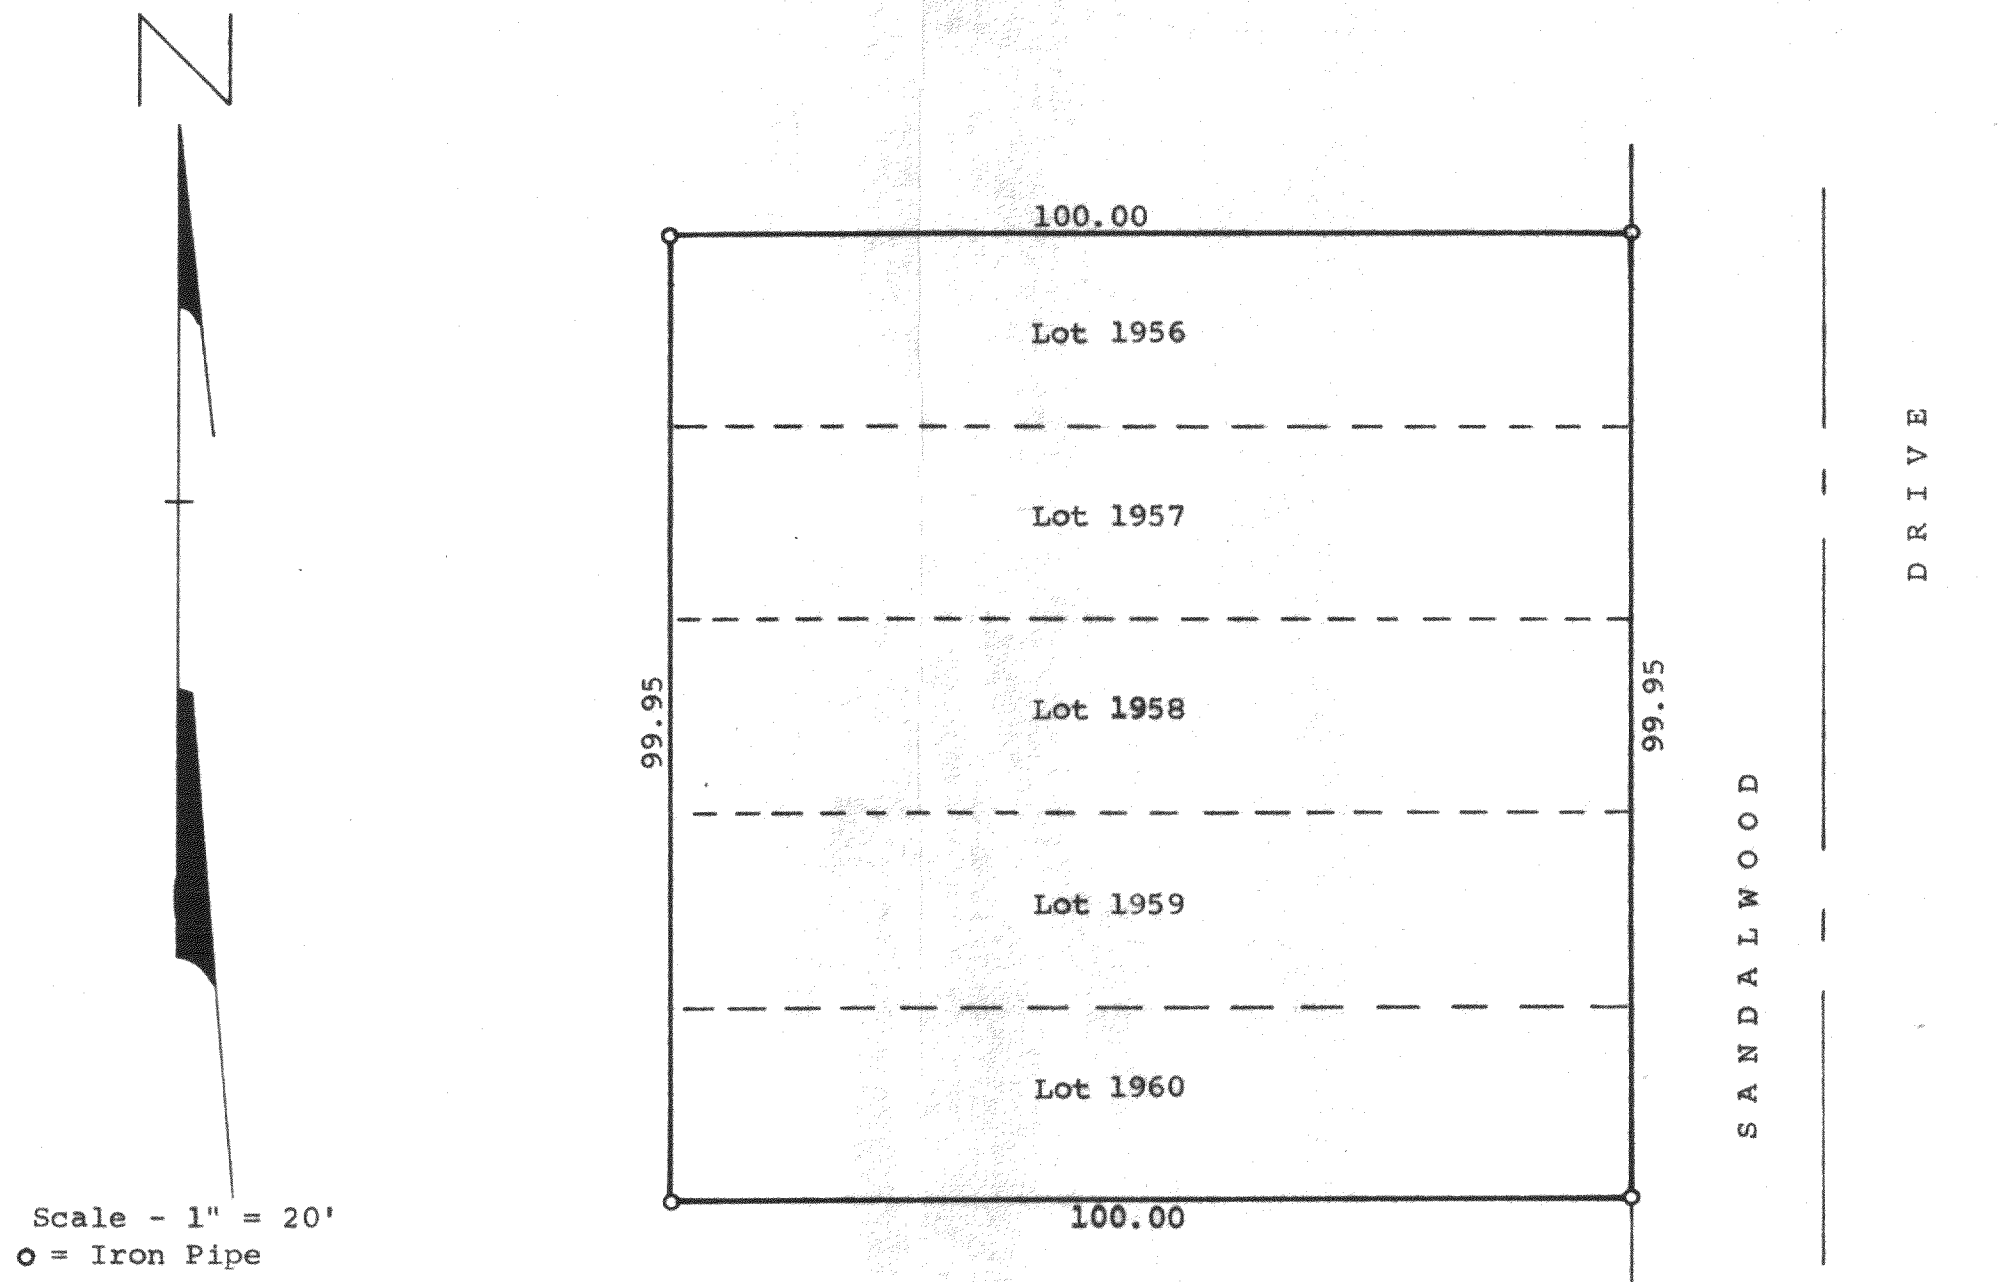

STATE OF WISCONSIN)  
COUNTY OF WALWORTH) SS

I, George T. Dunham, Surveyor, certify that I have surveyed  
the property described as follows,

Lots 1956-1960 inclusive, Block 55 of Pell Lake Subdivision  
located in Section 22, T 1 N, R 18 E, Walworth County,  
Wisconsin,

and the above map is a true representation thereof and shows the size  
and location of the property, its exterior boundaries, the location and  
dimensions of all structures thereon, fences, apparent easements and  
roadways and visible encroachments, if any.  
This survey is made for the exclusive use of the present owners of the  
property, and also those who purchase, mortgage, or guarantee the title  
thereto within one (1) year from date hereof; and as to them I warrant  
the accuracy of said survey and map.  
December 22, 1976

*George T. Dunham*  
George T. Dunham, Surveyor

