


HAROLD H. KOLB

REGISTERED PROFESSIONAL LAND SURVEYOR
LAKE GENEVA, WISCONSIN

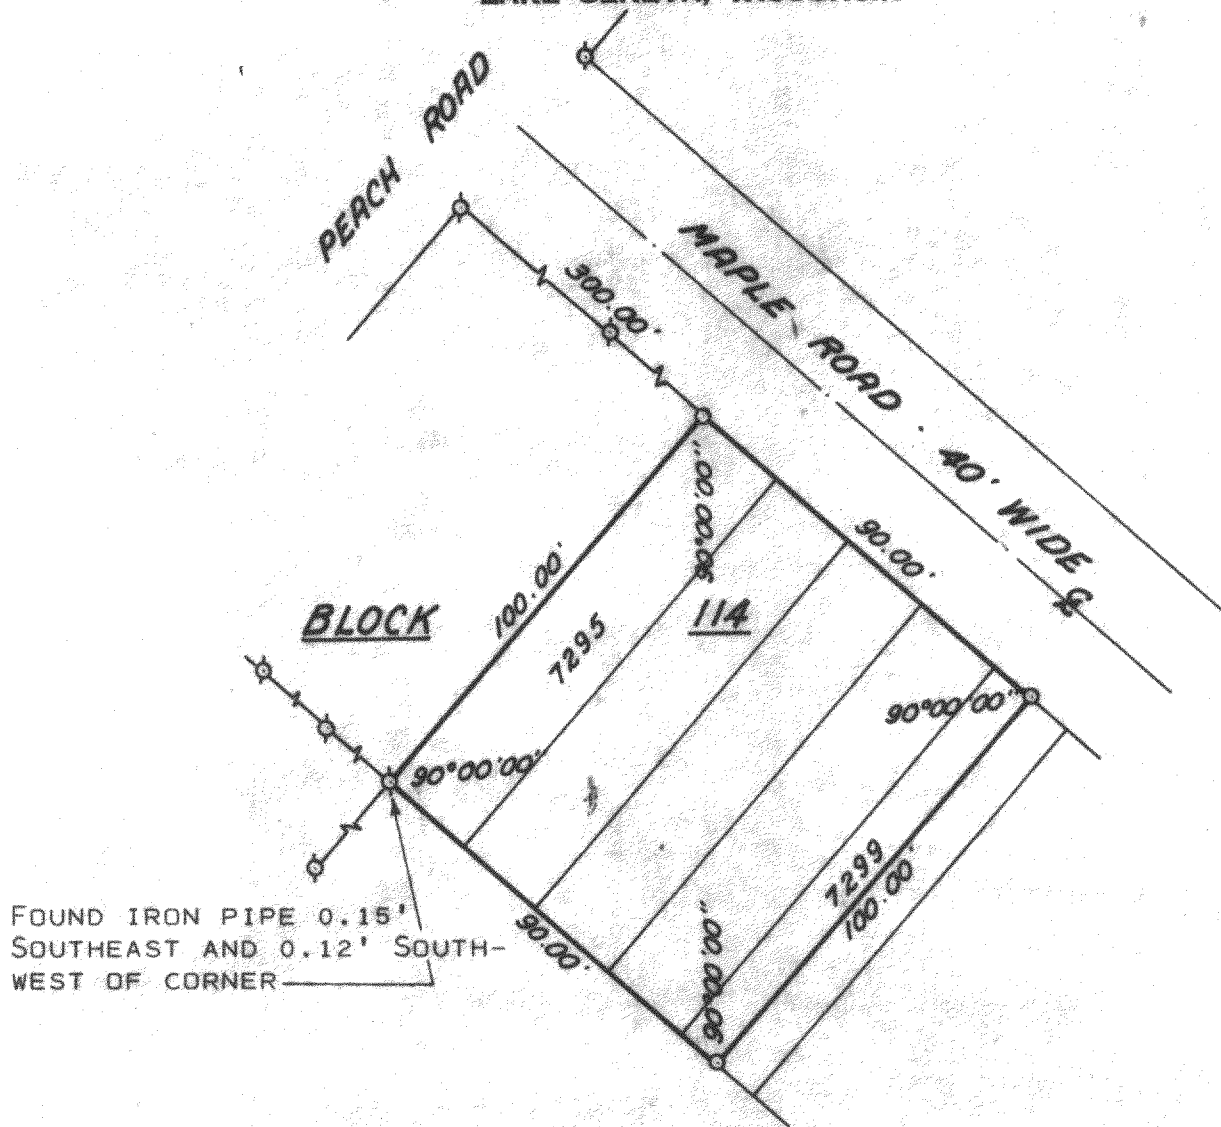


PLAT OF SURVEY OF

LOTS 7295-7298 AND THE NORTHWEST 1/2
OF LOT 7299, BLOCK 114, PELL LAKE
SUBDIVISION-SEC. A, T 1 N, R 18 E,
WALWORTH COUNTY, WISCONSIN.

OWNER: RICHARD KINSLEY

ACCURACY: DISTANCES $\pm 0.01'$
ANGLES $\pm 05''$
ERROR OF CLOSURE-
LESS THAN ONE PART IN 3000.

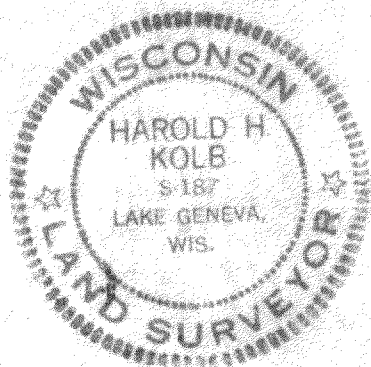

LEGEND

Ø-IRON PIPE FOUND
○-IRON PIPE PLACED

Harold H. Kolb
HAROLD H. KOLB
WISCONSIN REGISTERED LAND SURVEYOR, S-187
DATE *Dec. 24, 1976*

118-548