


DUNHAM SURVEYING, S.C.
SURVEYING & SUBDIVIDING
DELAVAN, WISCONSIN 53115

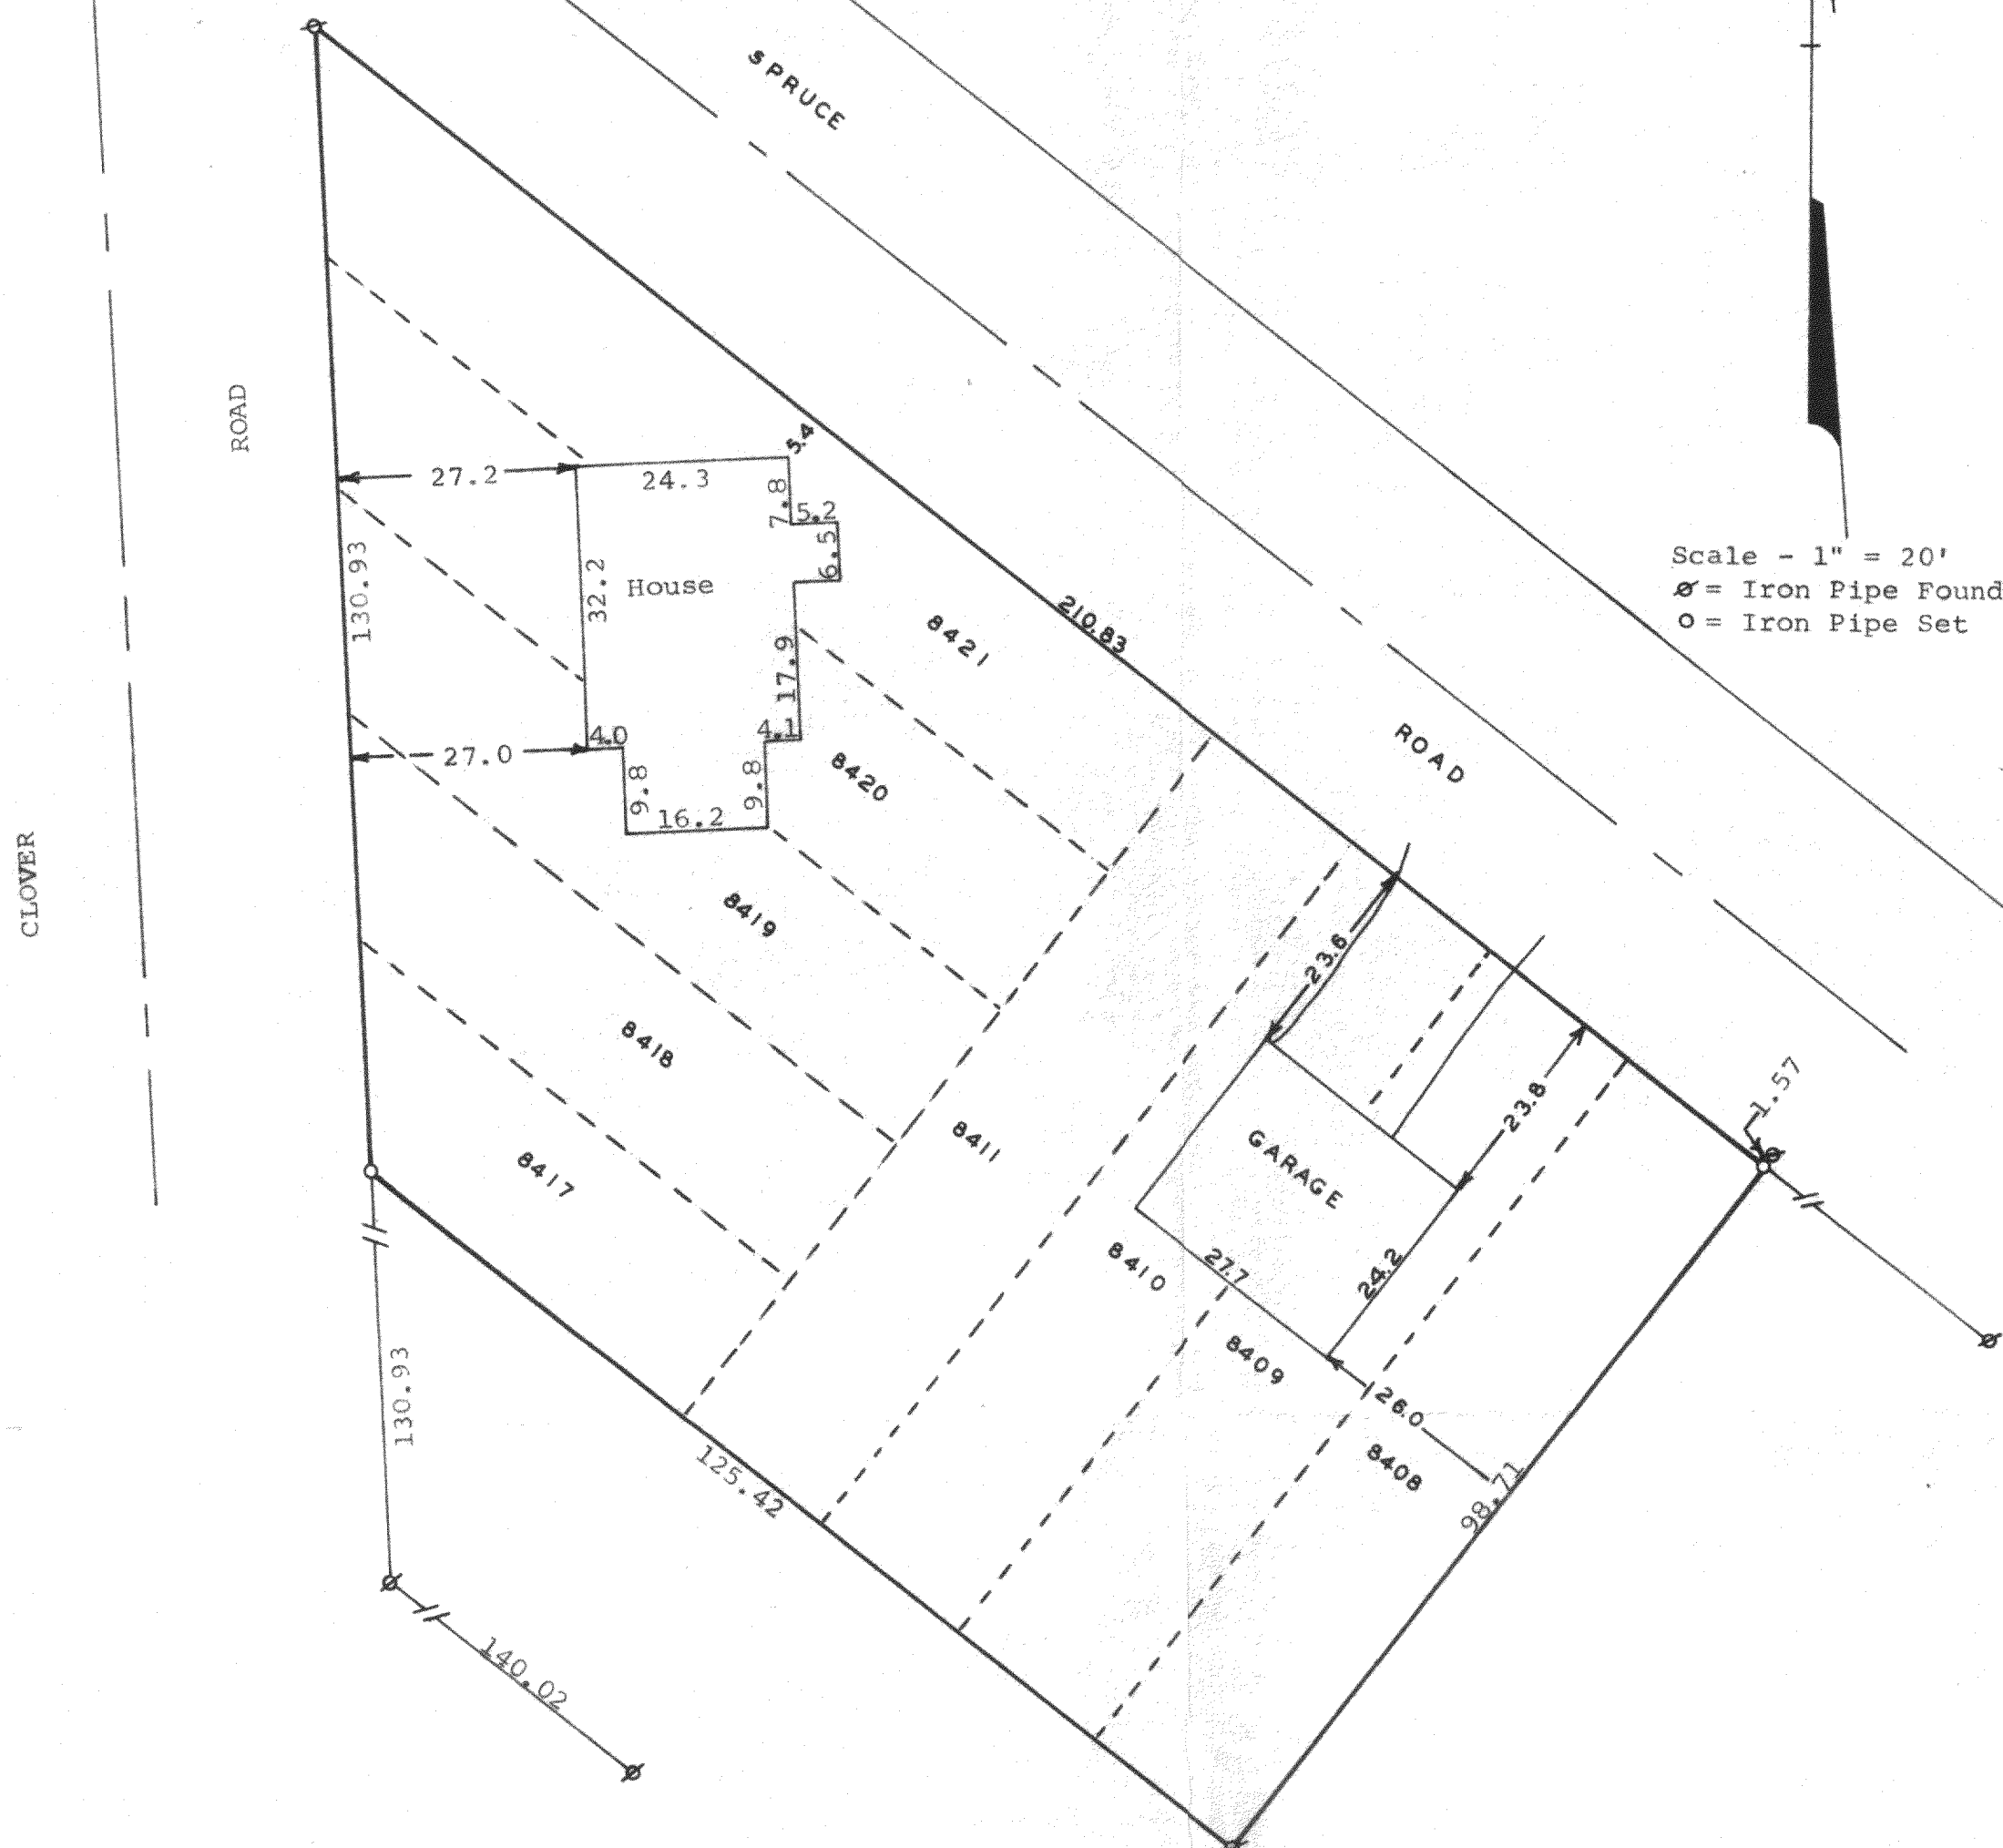

STATE OF WISCONSIN) SS
COUNTY OF WALWORTH)

I, George T. Dunham, Surveyor, certify that I have surveyed the property described as follows,


Lots 8408, 8409, 8410, 8411, 8417, 8418, 8419, 8420 and 8421 all in Section 5 of Pell Lake, located in Section 22, T1N, R18E, Walworth County, Wisconsin,

and the above map is a true representation thereof and shows the size and location of the property, its exterior boundaries, the location and dimensions of all structures thereon, fences, apparent easements and roadways and visible encroachments, if any.

This survey is made for the exclusive use of the present owners of the property, and also those who purchase, mortgage, or guarantee the title thereto within one (1) year from date thereof; and as to them I warrant the accuracy of said survey and map.

February 25, 1977

George T. Dunham
George T. Dunham, Surveyor

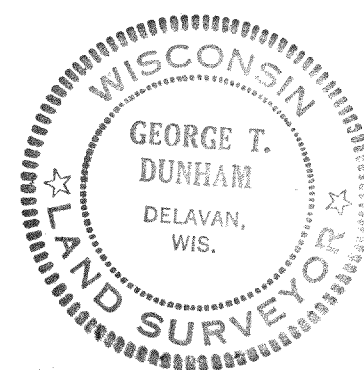

118-567