


SURVEYING & SUBDIVIDING  
DELAN, WISCONSIN 53115



the property described as follows.

and the above map is a true representation thereof and shows the size and location of the property, its exterior boundaries, the location and dimensions of all structures thereon, fences, apparent easements and roadways and visible encroachments, if any.

George D. Dunham  
George D. Dunham, Surveyor

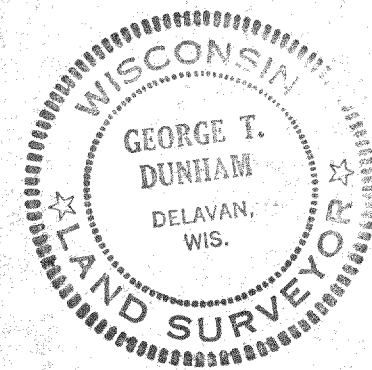

MCS - 391-1

118-579