

WHITEWATER, WISCONSIN 53190

FRANKLIN PARK, 1E 00151

CLOVER ROAD 49.5' WIDE

LOT 1850

LOT 1845

POST ROAD 50' WIDE

UTILITY LINES

FENCE ENCROACHES

100.00' 99.98'

38.2'

30.2'

24.3'

24.3'

30.2'

24.3'

38.0'

27.4'

15.0'

119.00'

140.00'

99.87' 99.87' (100.00')

99.73' (100.00')

SHED ON CONC. SLAB.

GAS METER

STEPS

7" IRON PIPE FOUND 0.16' NORTH OF CORNER


TREE AT CORNER

NOT TO SCALE

LOTS 1845-1850, BLOCK 41, PELL LAKE SUB-DIVISION, WALWORTH COUNTY, WISCONSIN.

THIS SURVEY IS MADE FOR THE USE OF THE PRESENT OWNERS OF THE PROPERTY AND ALSO THOSE WHO PURCHASE, MORTGAGE, OR GUARANTEE THE TITLE THERETO WITHIN ONE (1) YEAR FROM DATE HEREOF.

HAROLD H. KOLB
WISCONSIN REGISTERED LAND SURVEYOR, S- 187
DATE July 11, 1979

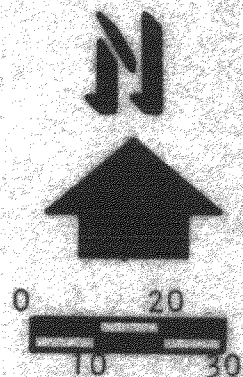

SCALE IN FEET

LEGEND:

- - IRON PIPE FOUND
- - IRON PIPE PLACED
- Y- FENCE
- () - AS PLATTED

