
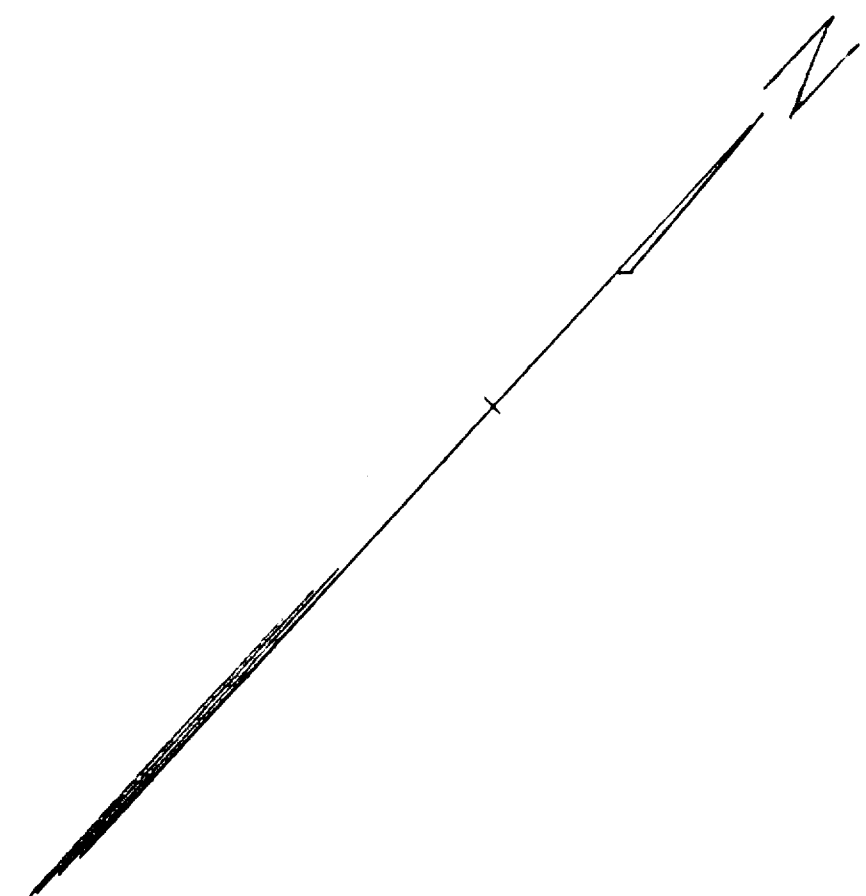


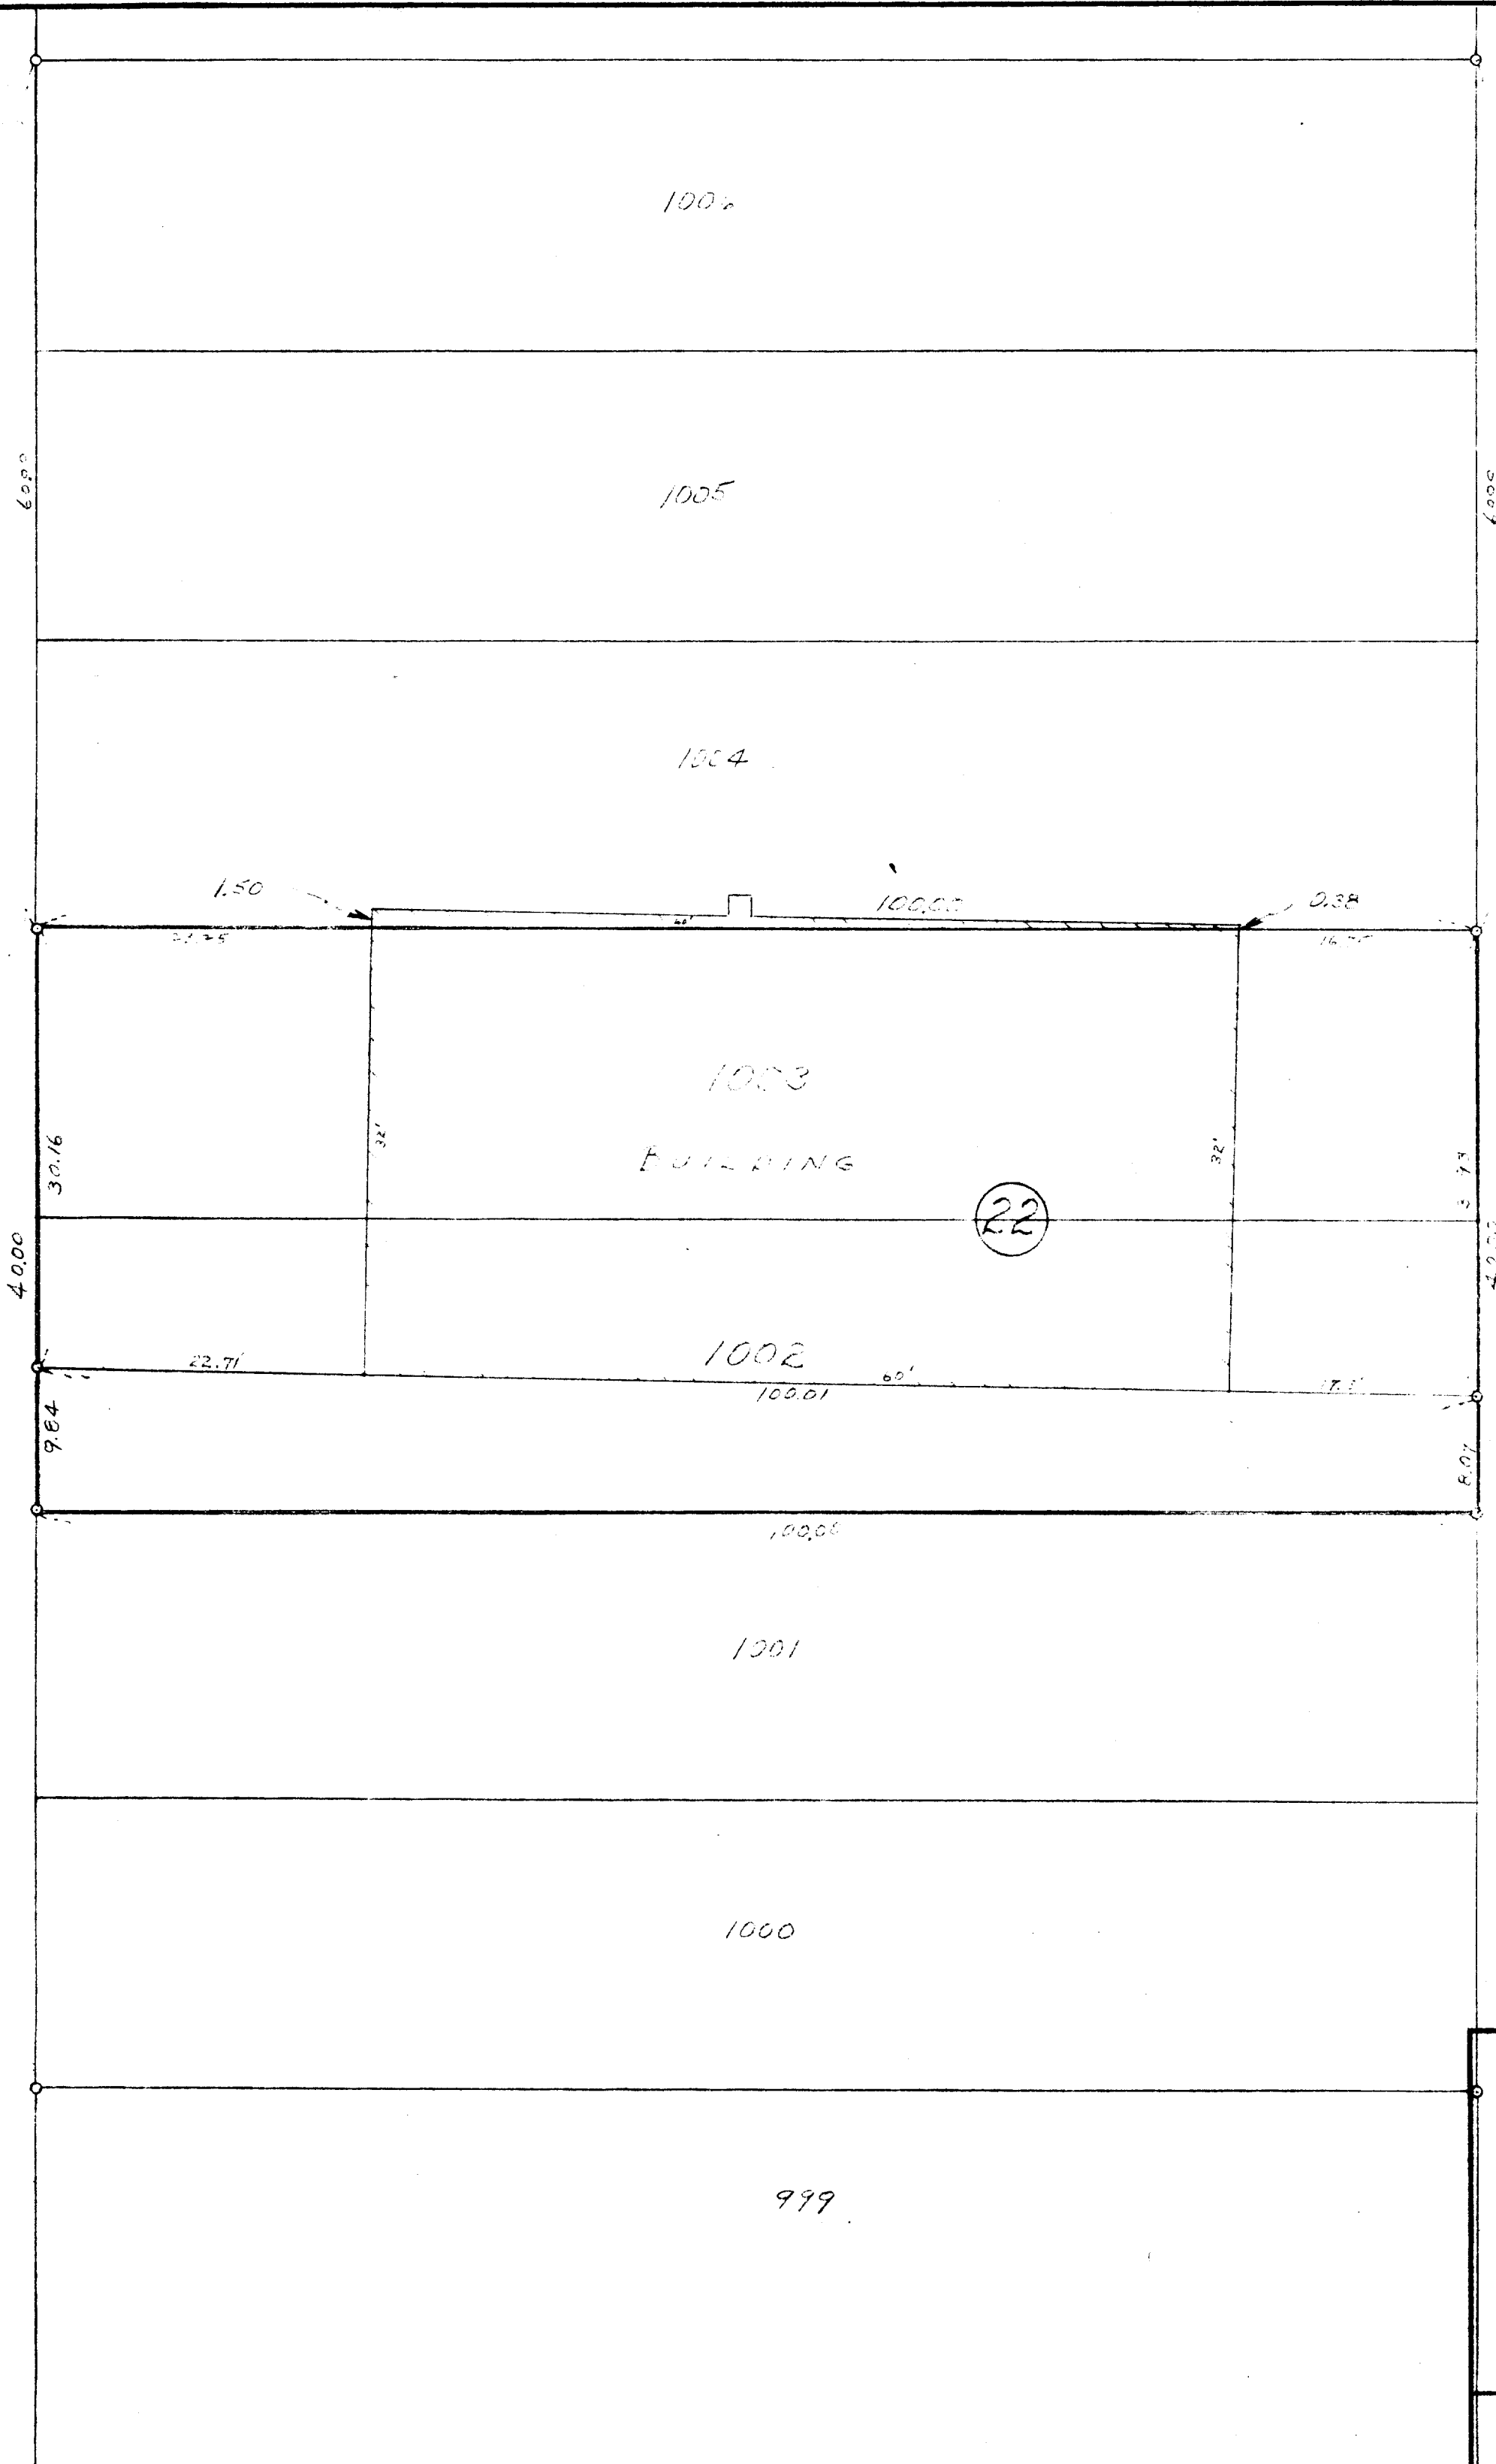

PARK ROAD

O - IRON PIPE

PLAT OF SURVEY
OF

LOTS 1002 AND 1003 OF
BLOCK 22 SECTION 1

PELL LAKE TOWNSHIP
WALWORTH COUNTY, WISCONSIN

Cloyd Jensen
SURVEYOR

SCALE 1" = 10'

DATE APRIL 1954