


DUNHAM & RASMUSSEN
SURVEYING & ENGINEERING
DELAVAN, WISCONSIN

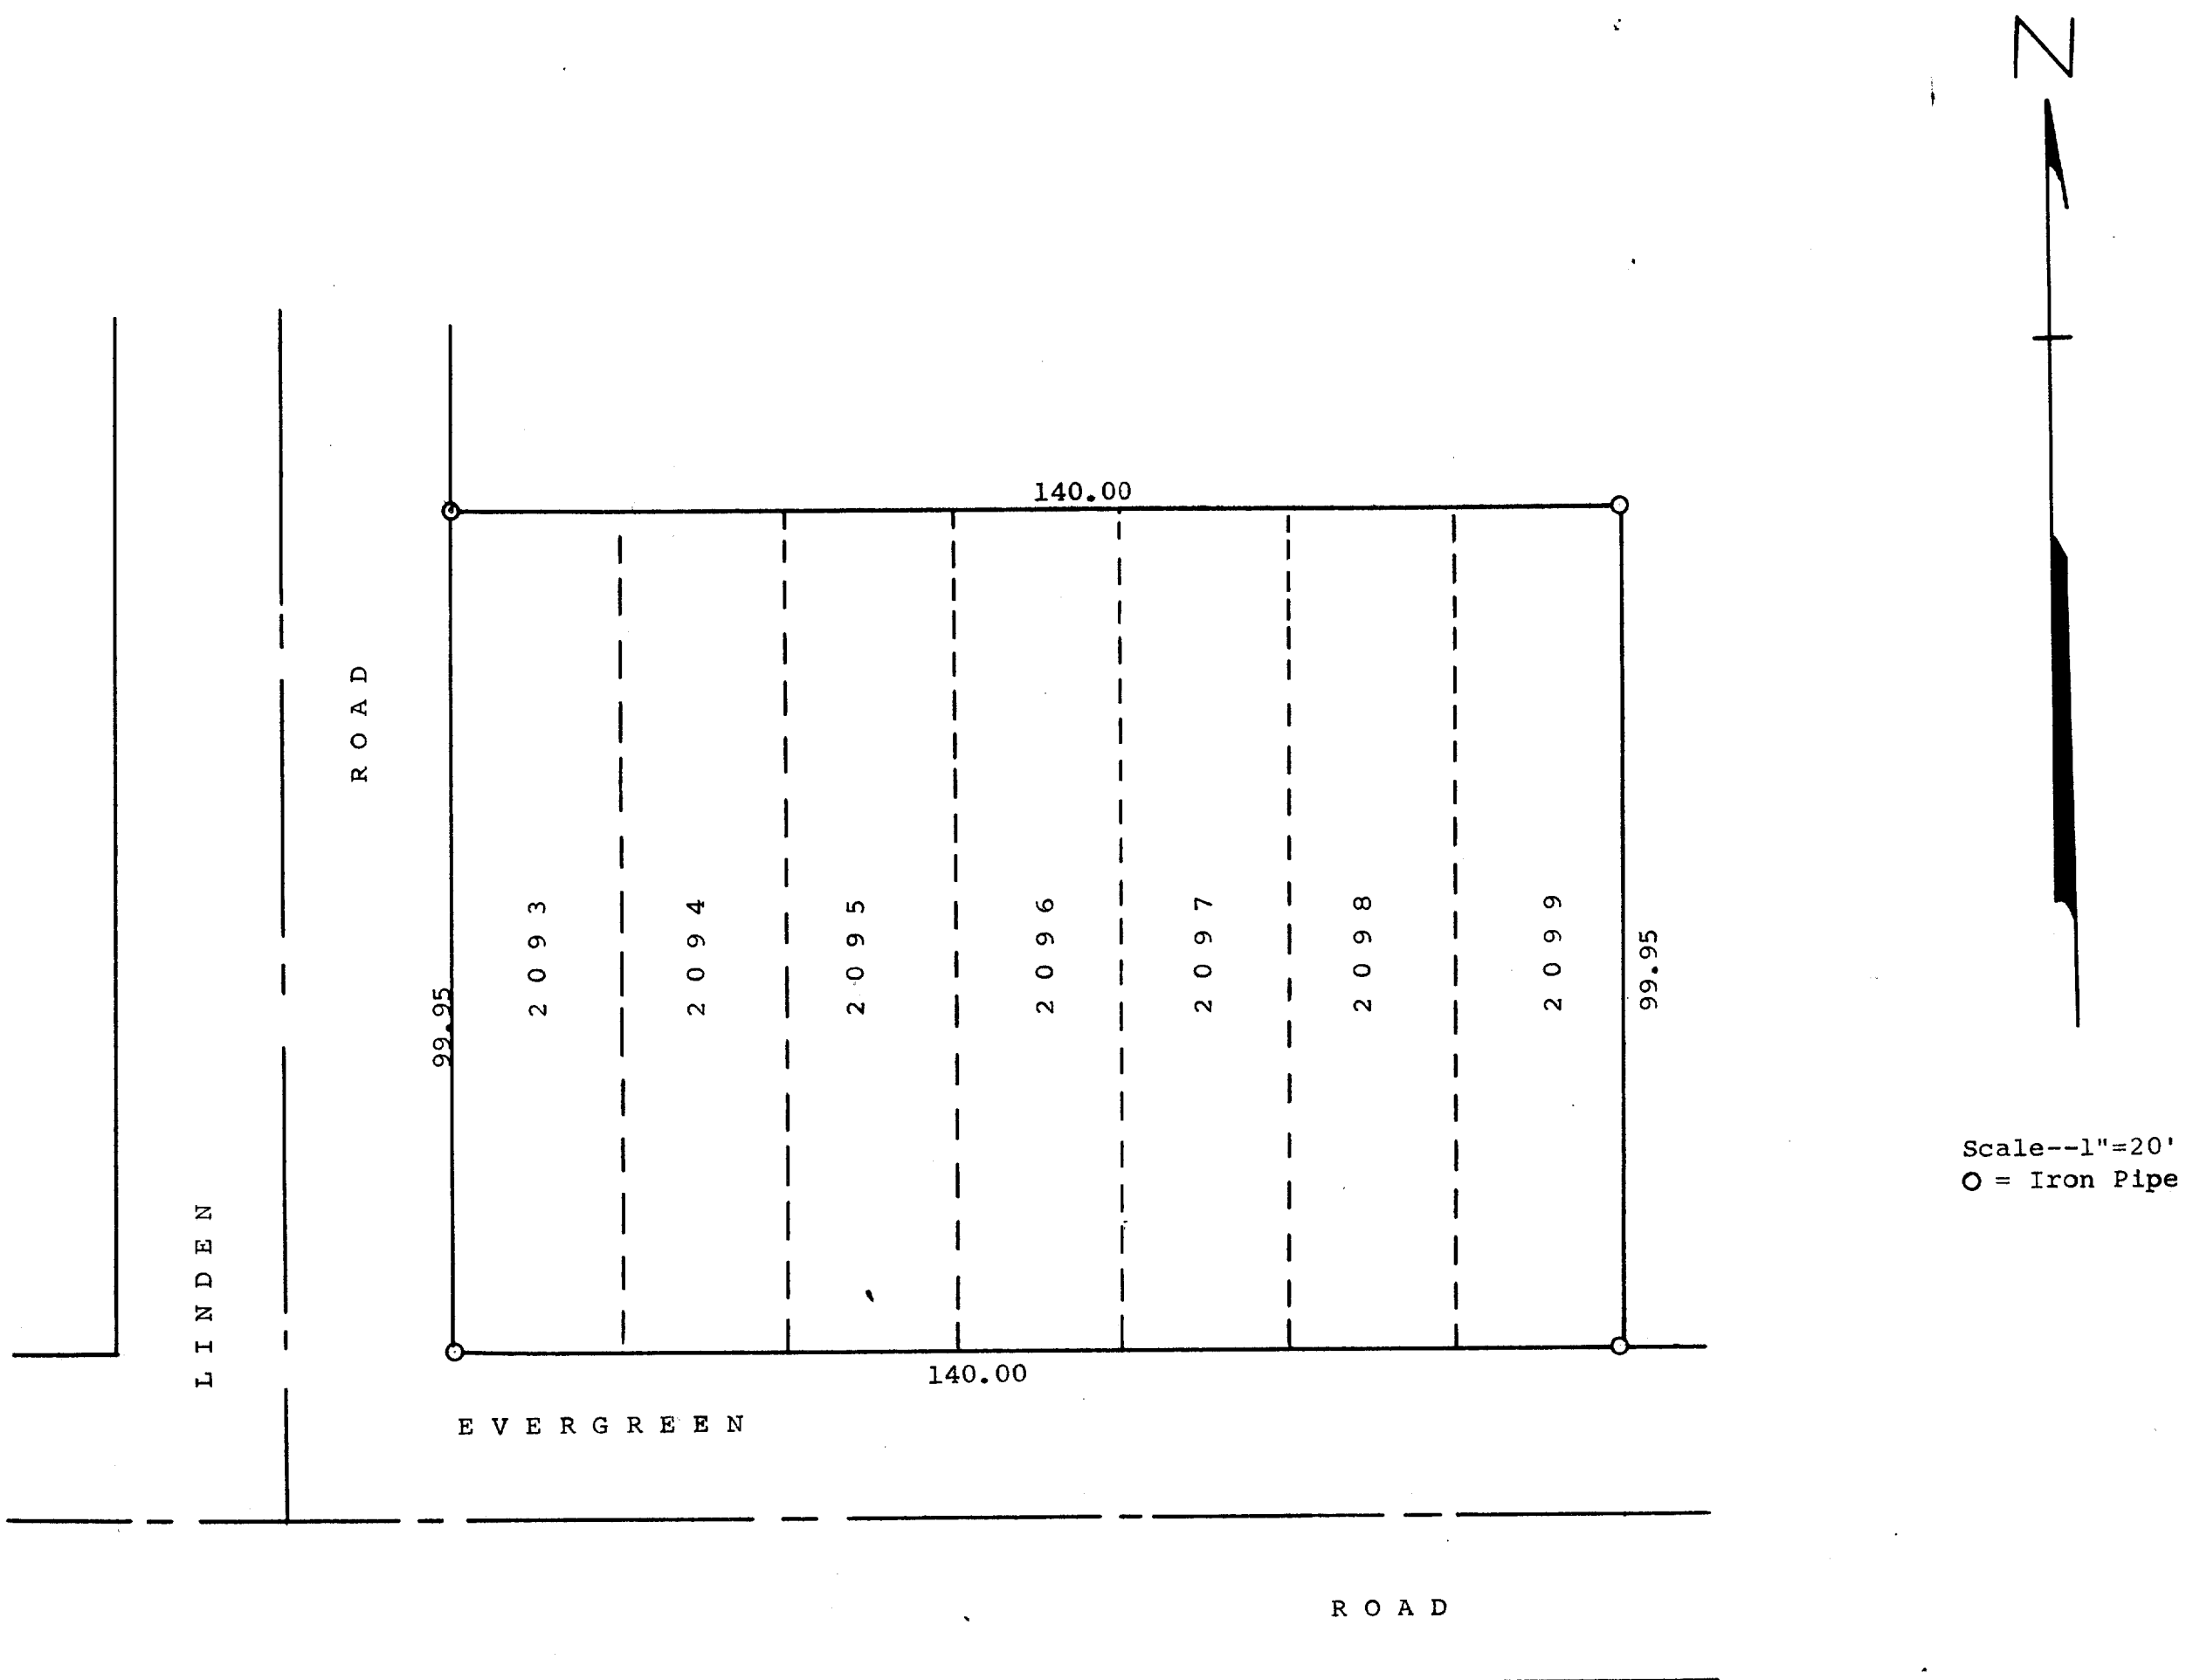

Plat of survey of Lots 2093-2099 Inclusive of Pell Lake
Subdivisions, Town of Bloomfield, Walworth County, Wisconsin
October 11, 1961

George T. Dunham
George T. Dunham, Surveyor