


KOLB LAND CONSULTING, INC.  
LAND SURVEYING • SUBDIVIDING • LAND PLANNING

LAKE GENEVA, WISCONSIN 53147

WHITEWATER, WISCONSIN 53190

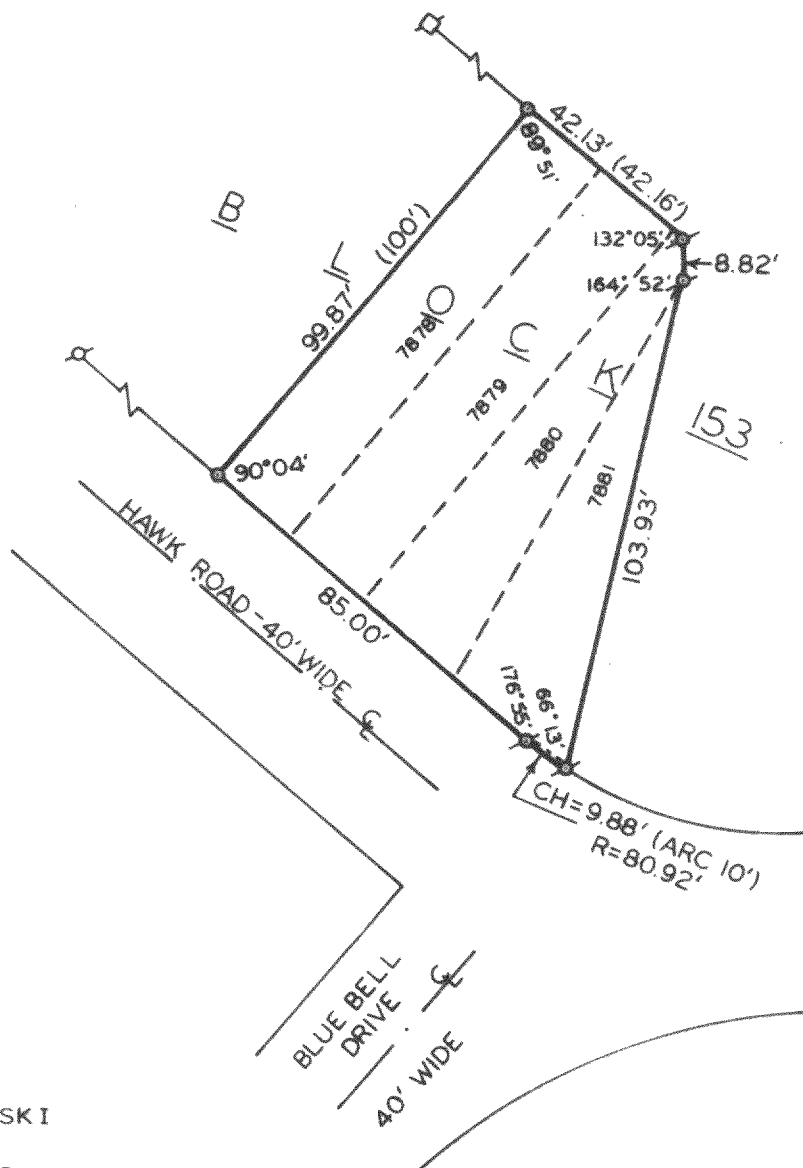


OWNER:

ALDIS RECZYNSKI  
P.O. BOX 450  
PELL LAKE, WI 53157

PLAT OF SURVEY OF

LOTS 7878-7881, BLOCK 153, SECTION  
5, PELL LAKE SUBDIVISION, TOWN 1  
NORTH, RANGE 18 EAST, WALWORTH  
COUNTY, WISCONSIN.

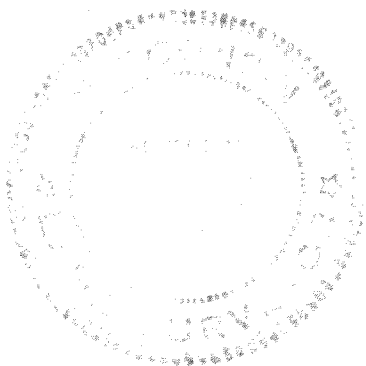

SCALE: 1"=40'

LEGEND

- σ - IRON PIPE FOUND
- - SQUARE IRON ROD FOUND
- o - IRON PIPE SET
- ( ) - RECORDED AS

I, ROBERT M. BAERENWALD, DO HEREBY CERTIFY THAT I  
HAVE SURVEYED THE PROPERTY HEREON DESCRIBED ACCORD-  
ING TO THE OFFICIAL RECORDS, AND THAT THE PLAT  
HEREON IS A CORRECT REPRESENTATION OF THE LOT LINES  
TO THE BEST OF MY ABILITY AND BELIEF.

*Robert M. Baerenwald*  
ROBERT M. BAERENWALD  
WISCONSIN REGISTERED LAND SURVEYOR, S-1508  
DATE *July 3, 1980*

118-624 K