


DUNHAM SURVEYING, S.C.
SURVEYING & SUBDIVIDING
DELAVER, WISCONSIN 53115

MARINETTE

ROAD

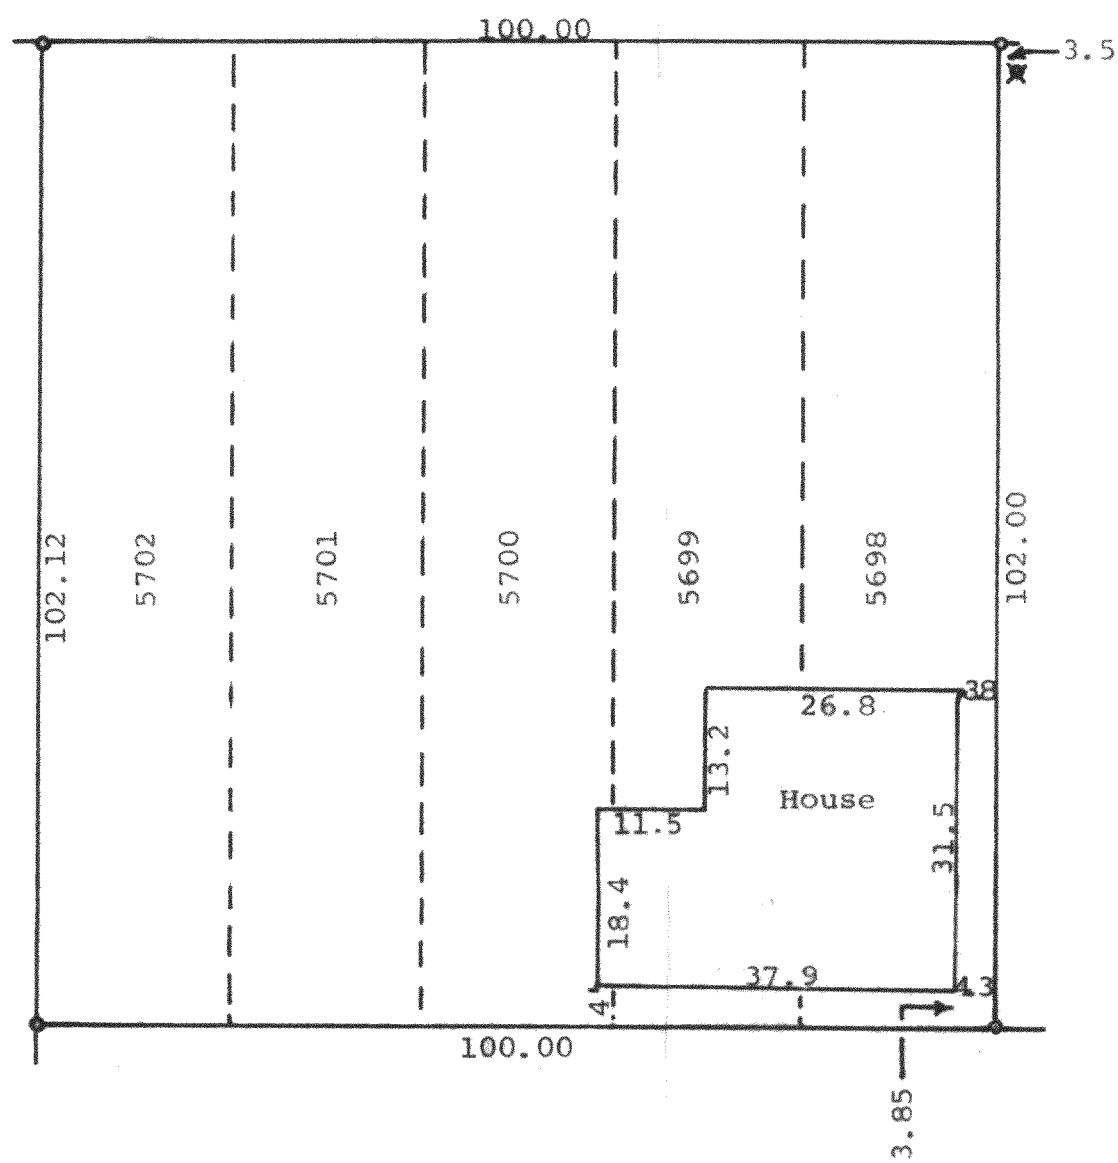

Scale - 1" = 20'
● = Iron Pipe
✕ = Utility Pole

STATE OF WISCONSIN)
COUNTY OF WALWORTH) SS

I, George T. Dunham, Surveyor, certify that I have surveyed the property described as follows:

Lots 5698-5702 inclusive, Section 3 of Pell Lake Subdivisions, located in Section 15, T1N, R18E, Walworth County, Wisconsin, and that the above map is a true representation thereof and shows the size and location of the property, its exterior boundaries, the location of all visible structures and dimensions of all principal buildings thereon, boundary fences, apparent easements, roadways and visible encroachments, if any.

This survey is made for the use of the present owners of the property, and also those who purchase, mortgage, or guarantee the title thereto within one (1) year from date hereon.

June 23, 1980

George T. Dunham
George T. Dunham, Surveyor

