
KOLB LAND CONSULTING, INC.

LAND SURVEYING . SUBDIVIDING . LAND PLANNING

LAKE GENEVA, WISCONSIN 53147

WHITEWATER, WISCONSIN 53190



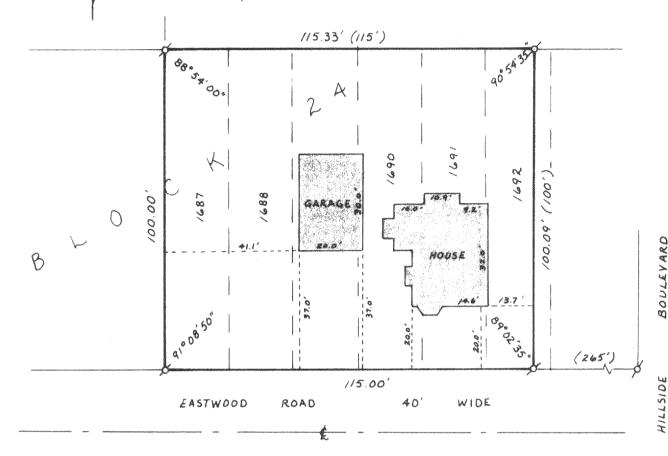


PLAT OF SURVEY OF

SCALE: 1"=30"

LOTS 1687-1691 AND LOT 1692 EXCEPT THE EAST 5 FEET, BLOCK 24, PELL LAKE HIGHLANDS SUBDIVISION, WALWORTH COUNTY, WISCONSIN.

ORDERED BY: MICHAEL MARCHUK

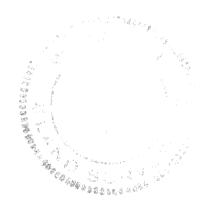

I, HAROLD H. KOLB, DO HEREBY CERTIFY THAT I HAVE SURVEYED THE PROPERTY HEREON DESCRIBED ACCORDING TO THE OFFICIAL RECORDS, AND THAT THE PLAT HEREON IS A CORRECT REPRESENTATION OF THE LOT LINES TO THE BEST OF MY KNOWLEDGE AND BELIEF.

LEGEND

Ø- IRON PIPE FOUND

() - RECORDED AS

MAROLD H. KOLB WISCONSIN REGISTERED LAND SURVEYOR, S- 187

DATE JULIA