


DUNHAM SURVEYING, S. C.
SURVEYING & SUBDIVIDING
DELAVAN, WISCONSIN 53115

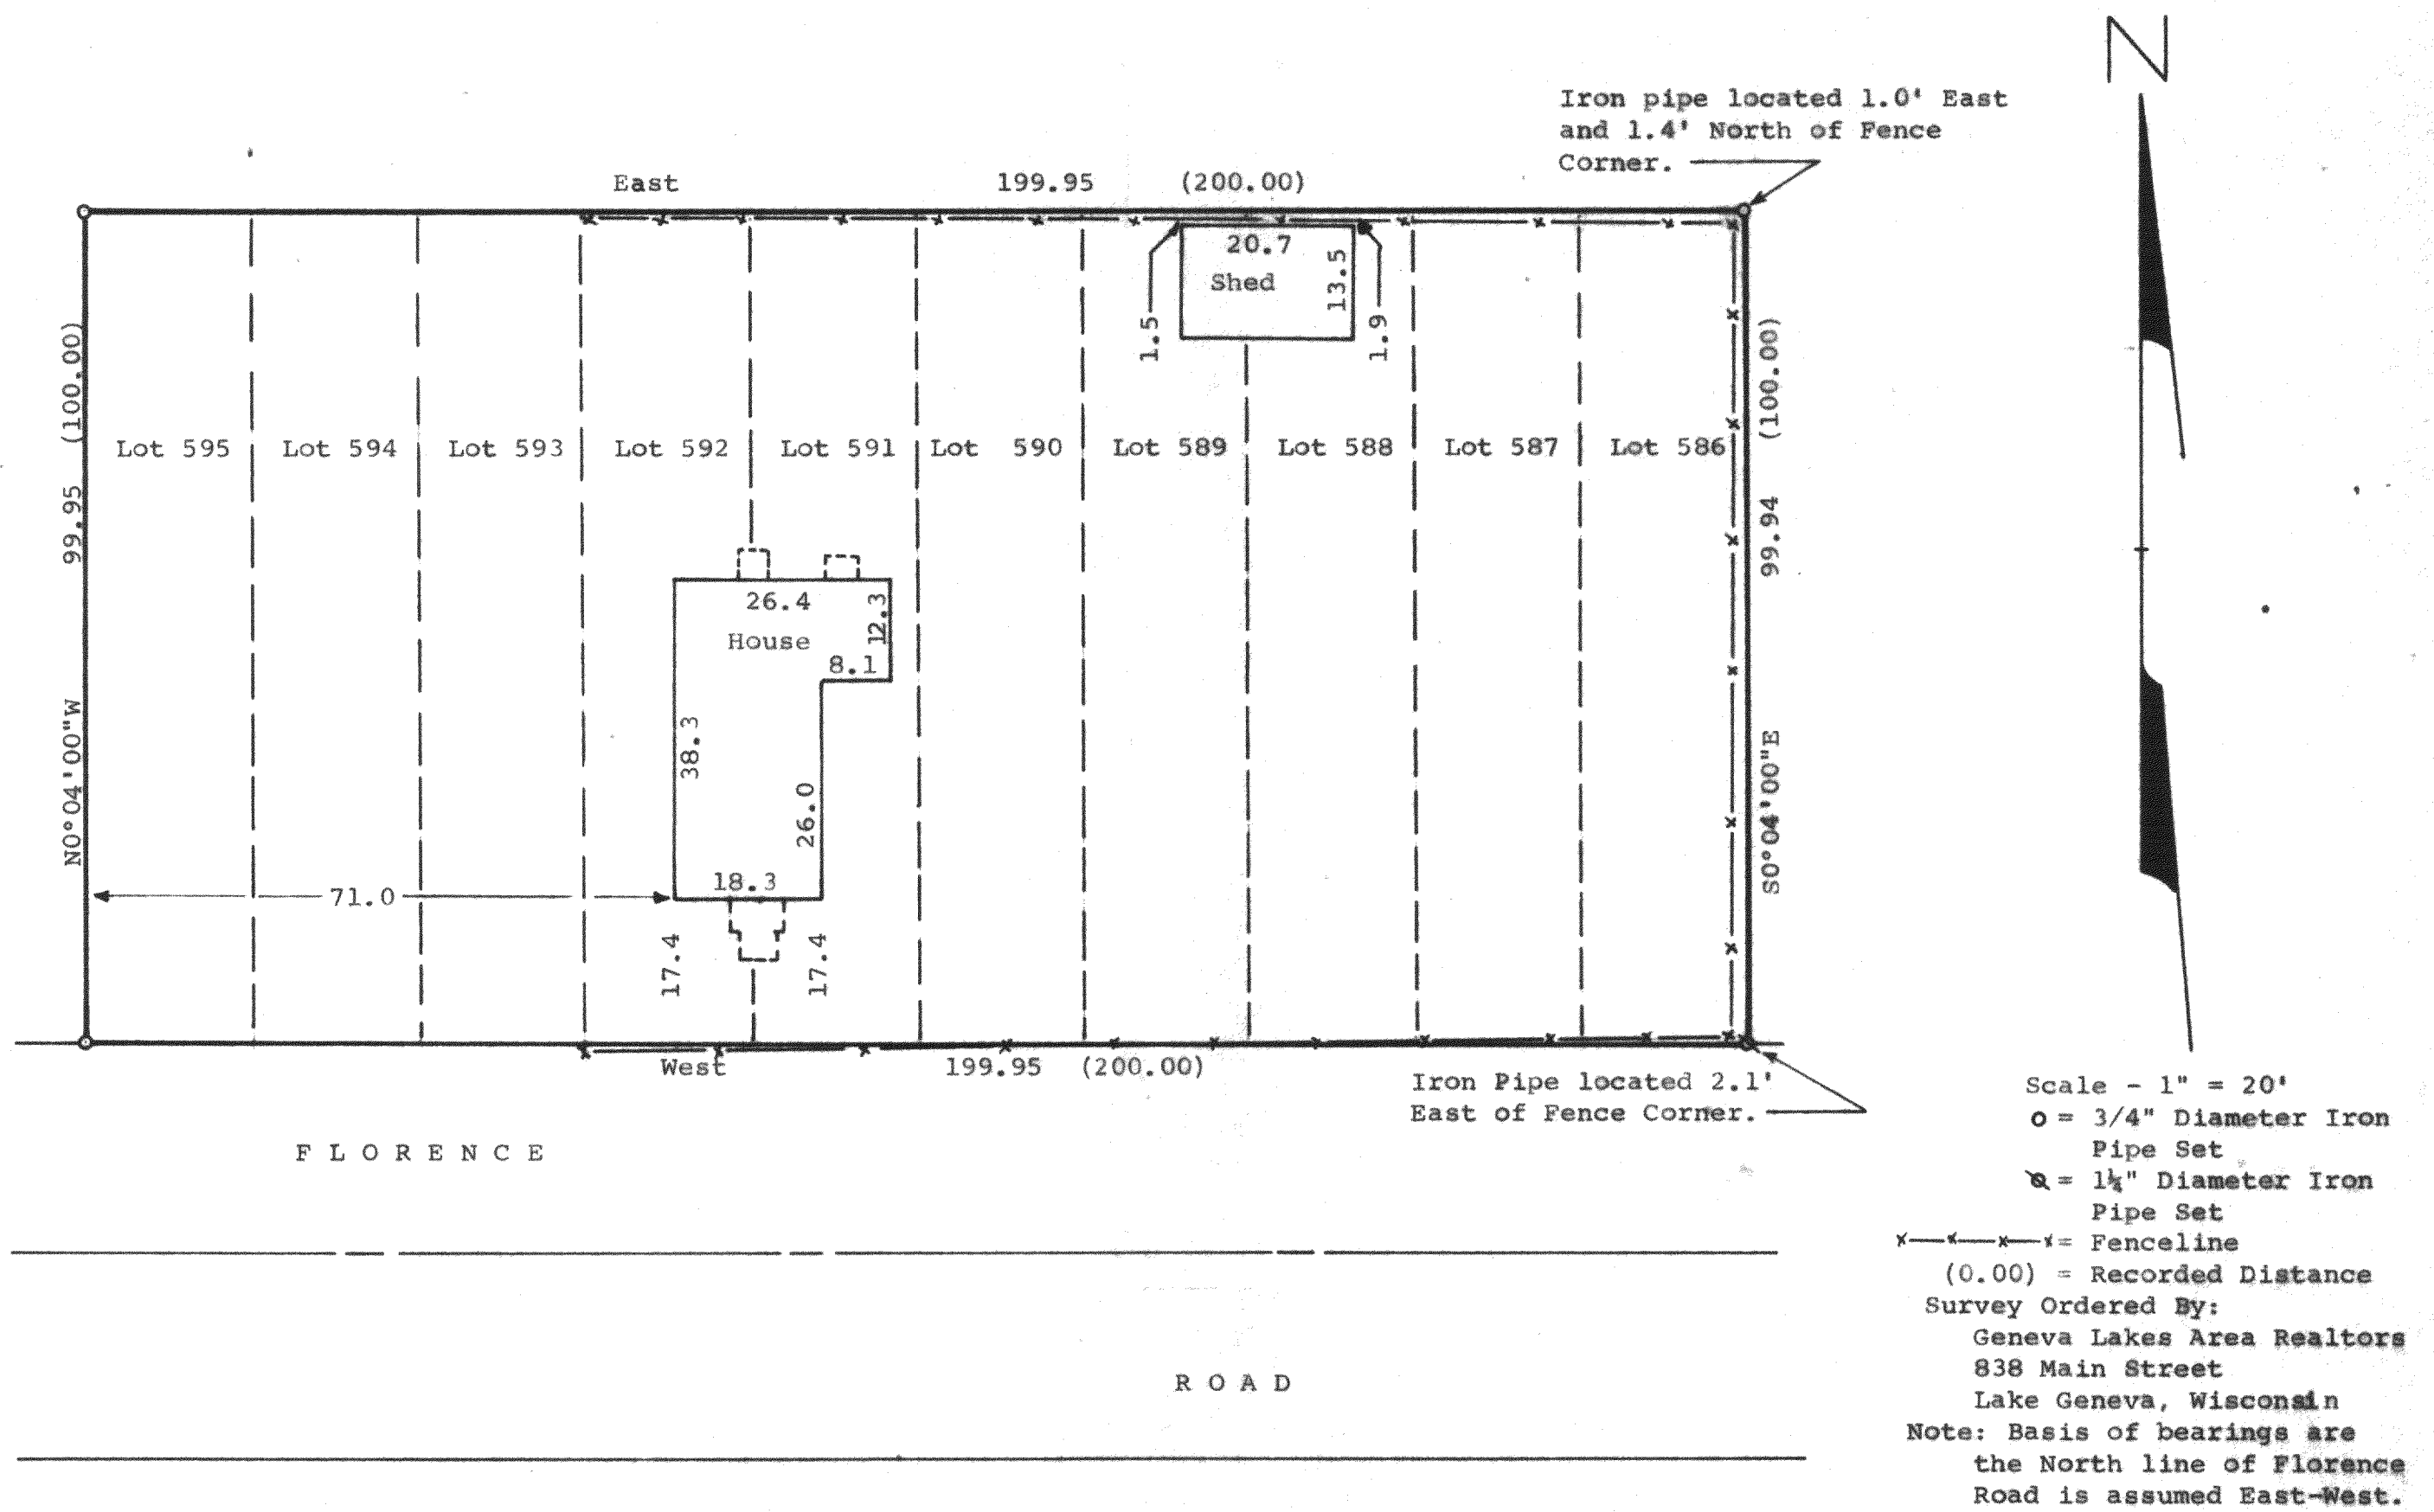

STATE OF WISCONSIN) SS
COUNTY OF WALWORTH)


I, Richard C. Schulz, Surveyor, certify that I have surveyed the property described as follows,

Lots 586 to 595, inclusive, in Block 10, Pell Lake Addition, located in Section 14, T1N, R18E, Walworth County, Wisconsin, and that the above map is a true representation thereof and shows the size and location of the property, its exterior boundaries, the location of all visible structures and dimensions of all principal buildings thereon, boundary fences, apparent easements, roadways and visible encroachments, if any.

This survey is made for the use of the present owners of the property, and also those who purchase, mortgage, or guarantee the title thereto within one (1) year from date hereof.

May 24, 1982.

Richard C. Schulz
Richard C. Schulz, Surveyor

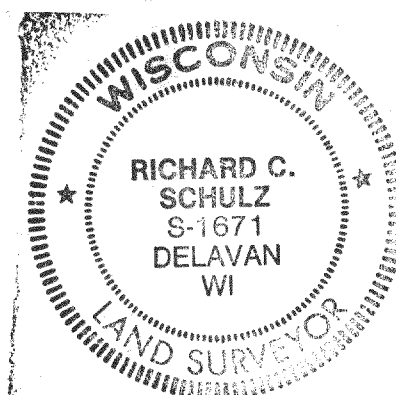

Lots 586 to 595 Block 10 Pell Lake Add

118-640-D