



KOLB LAND CONSULTING, INC.
 LAND SURVEYING · SUBDIVIDING · LAND PLANNING

LAKE GENEVA, WISCONSIN 53147

NOTE: BLOCK 115 OF PELL
 LAKE SUB. ENCROACHES ON
 THE FORMER RAILROAD R.O.W.

NOTE: BEARINGS ASSUMED AS
 SHOWN ON THE SUBDIVISION
 PLAT OF PELL LAKE.


ORDERED BY: NICHOLAS
 IWASZYNSKI
 5825 MAPLE AVE.
 BERKELEY, IL 60163

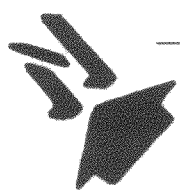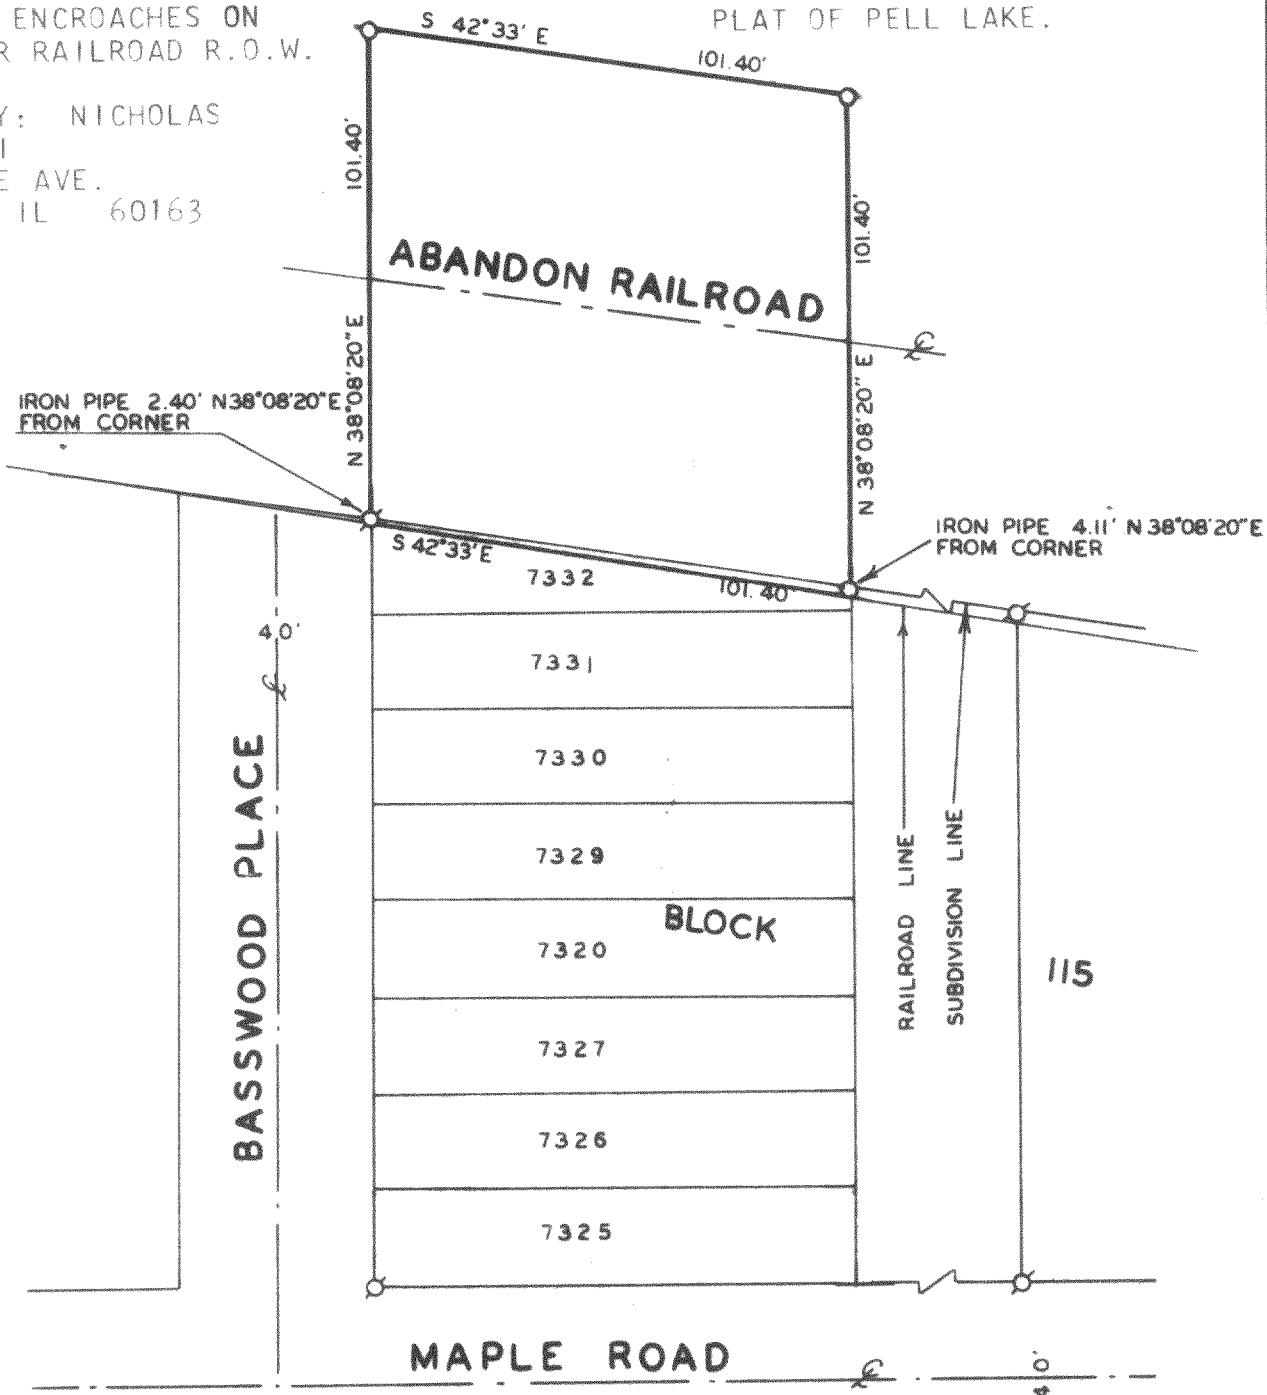

SCALE 1" = 40'

PLAT OF SURVEY OF
 A PARCEL OF LAND LOCATED IN THE SOUTHWEST 1/4
 OF THE SOUTHEAST 1/4 OF SECTION 16 AND THE NORTH-
 WEST 1/4 OF THE NORTHEAST 1/4 OF SECTION 21, T1N,
 R18E, WALWORTH COUNTY, WISCONSIN AS DESCRIBED IN
 VOLUME 320 PAGE 133 OF RECORDS.

- LEGEND
 ⚡ - IRON PIPE FOUND
 ○ - IRON PIPE SET

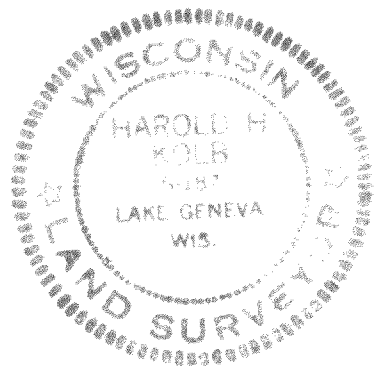

I, HAROLD H. KOLB, DO HEREBY CERTIFY
 THAT I HAVE SURVEYED THE PROPERTY
 HEREON DESCRIBED ACCORDING TO THE
 OFFICIAL RECORDS, AND THAT THE PLAT
 HEREON IS A CORRECT REPRESENTATION
 OF THE LOT LINES TO THE BEST OF MY
 KNOWLEDGE AND BELIEF.

Harold H. Kolb
 HAROLD H. KOLB
 WISCONSIN REGISTERED LAND SURVEYOR, S-187
 DATE May 18, 1984

218-655-K