


KOLB AND CONSULTING, INC.
 LAND SURVEYING • SUBDIVIDING • LAND PLANNING

LAKE GENEVA, WISCONSIN 53147

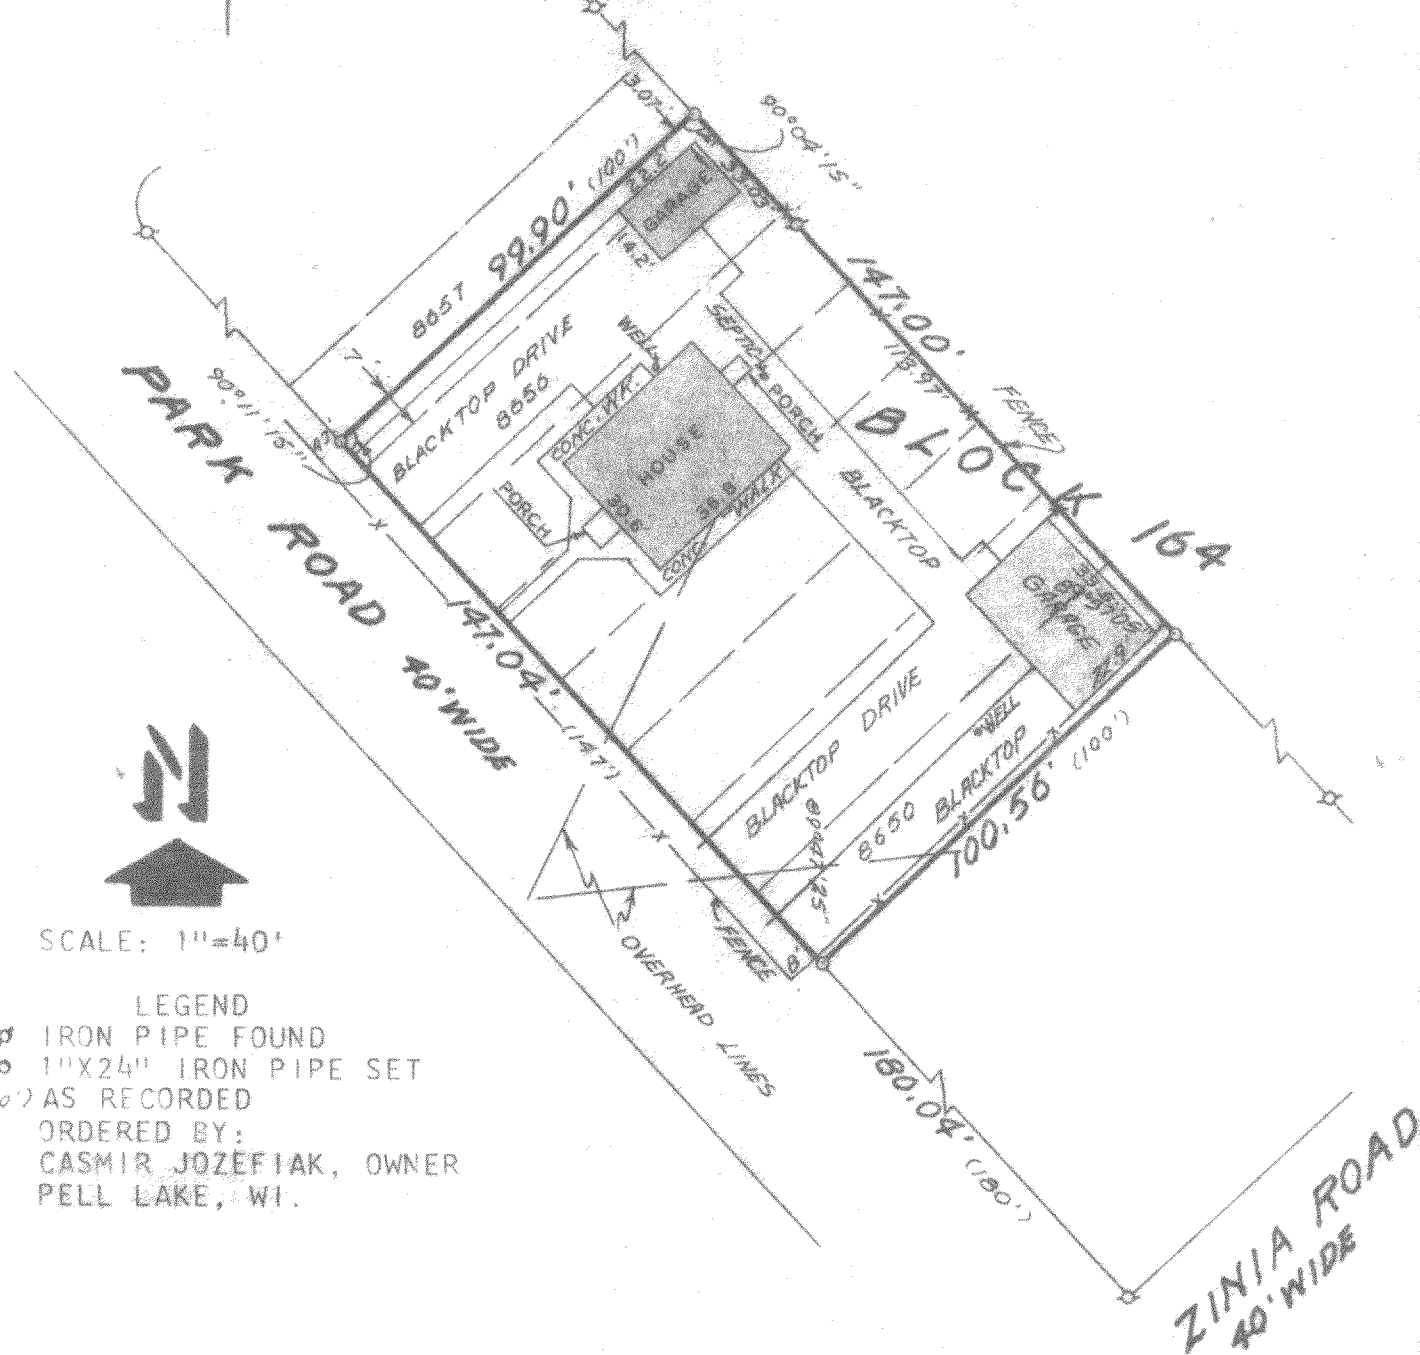


SCALE: 1"=40'

LEGEND
 ⚭ IRON PIPE FOUND
 ○ 1"X24" IRON PIPE SET
 (10) AS RECORDED
 ORDERED BY:
 CASMIR JOZEFIAK, OWNER
 PELL LAKE, WI.

PLAT OF SURVEY OF
 LOTS 8650-8656 AND THE SOUTHEASTERLY 7.00 FEET OF LOT 8657, BLOCK 164,
 PELL LAKE, A SUBDIVISION LOCATED IN SECTION 22, T 1 N, R 18 E, TOWN
 OF BLOOMFIELD, WALWORTH COUNTY, WISCONSIN.

I HEREBY CERTIFY THAT I HAVE SURVEYED THE ABOVE DESCRIBED PROPERTY AND THAT THE ABOVE MAP IS A TRUE REPRESENTATION THEREOF AND SHOWS THE SIZE AND LOCATION OF THE PROPERTY, ITS EXTERIOR BOUNDARIES, THE LOCATION OF ALL VISIBLE STRUCTURES AND DIMENSIONS OF ALL PRINCIPAL BUILDINGS THEREON, BOUNDARY FENCES, APPARENT EASEMENTS, ROADWAYS AND VISIBLE ENCROACHMENTS, IF ANY, TO THE BEST OF MY KNOWLEDGE AND BELIEF. THIS SURVEY IS MADE FOR THE USE OF THE PRESENT OWNERS OF THE PROPERTY, AND ALSO THOSE WHO PURCHASE, MORTGAGE, OR GUARANTEE THE TITLE THERETO WITHIN ONE (1) YEAR FROM THE DATE HEREOF.

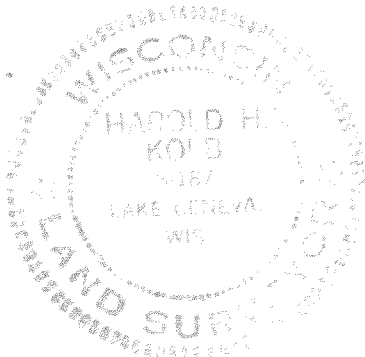

Harold H. Kolb

HAROLD H. KOLB
 WISCONSIN REGISTERED LAND SURVEYOR, S-187
 DATE MARCH 21, 1985

118-663K