

LAKE GENEVA, WISCONSIN

Block 101

5557 180.19'

5556

5555

5554

5553

20.2' GARAGE 20.2'

10.7' 16.6' 48.7' 11.3' 32.1' 22.0' 25.4' 25.7' 100.00'

CONCRETE PATIO

SEPTIC TANK

DRY WELL

RESIDENCE

75.45'

JUNEAU ROAD

207°47'45"

93.49'

R=104.04'

163°19'10"

70.95'

R=58.44'

49°43'05"




(140') 139.97'

89°57'30"

19.2' 19.5'

LOTS 5547-5557, BLOCK 101 OF PELL LAKE SUB-DIVISION, SECTION 3, LOCATED IN T 1 N, R 18 E, WALWORTH COUNTY, WISCONSIN.

ORDERED BY: MINNESOTA TITLE
250 NORTH SUNNY SLOPE
BROOKFIELD, WISCONSIN 53005

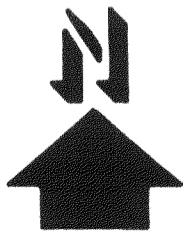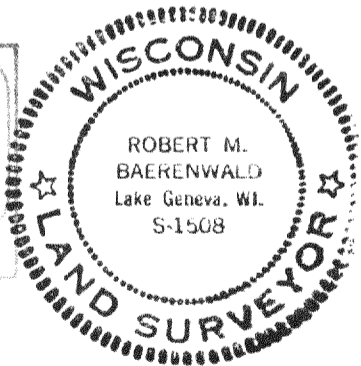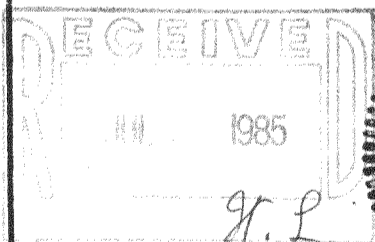

Ø-IRON PIPE FOUND
()-RECORDED AS

I, ROBERT M. BAERENWALD, DO HEREBY CERTIFY THAT I HAVE SURVEYED THE PROPERTY HEREON DESCRIBED ACCORDING TO THE OFFICIAL RECORDS AND THAT THE PLAT HEREON IS A CORRECT REPRESENTATION OF THE PROPERTY LINES TO THE BEST OF MY KNOWLEDGE AND BELIEF.

Robert M. Baerenwald
ROBERT M. BAERENWALD
WISCONSIN REGISTERED LAND SURVEYOR, S-1508

DATE Aug. 8, 1984

JOB NO. 0102

MPL-1200

115-669-13