HOME OFFICE 109 SOUTH SPRING STREET **BURLINGTON, WISCONSIN 53105** 414-763-7834

ROBERS & BOYD, INC.

CONSULTING ENGINEERS LAND SURVEYORS

BRANCH OFFICE 809 - 43RD STREET KENOSHA, WISCONSIN 53140

MORTGAGE INSPECTION for

Universal Mortgage of

Lots 1828, 1829, 1830, 1831, 1832, Block 41, PELL LAKE SUBD PEL Walwort.
SCONSINAL M 1 North, Range 18 East, Town of Bloomfield, Walworth County, Wisconsin.

OWNER: Robert & Shirley Dobshuetz

N. 1295 Ivy Drive Pell Lake, WI


I hereby certify that I have verified the improve ments as shown hereon this 11d day of February, 1986.

George J. Apper, RLS-1612

40

15

RIVE

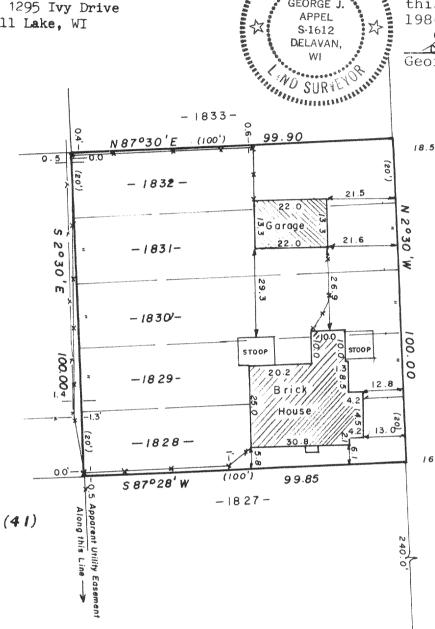

Note: This Mortgage Inspection was prepared for identification purposes for a real estate transaction. No corners were set. Do not use this map for establishing fences or construction.

"I hereby certify that I have surveyed the above described property and that the above map is a true representation thereof and shows the size and location of the property, its exterior boundaries, the location of all visible structures and dimensions of all principal buildings thereon, boundary fences, apparent easements, roadways and visible encroachments, if any.

This survey is made for the use of the present owners of the property, and also those who purchase, mortgage, or guarantee the title thereto within one year from date hereof."

YES MONUMENTATION HAS BEEN WAIVED IN ACCORDANCE WITH A-E 5.01(b) OF THE WISCONSIN ADMINISTRATIVE CODE.

5-13-82

DATE

PK NAIL FOUND PK NAIL SET FOUND IRON PIPE -FOUND IRON PIPE -SET IRON PIPE -FOUND BRASS CAPPED MONUMENT FOUND CONCRETE MONUMENT FENCE RECORDED AS EXISTING GROUND ELEVATION

LEGEND

SCALE-1" = 30'

689-R 86016 82058

JOB NUMBER

WISCONSIN REGISTERED LAND SURVEYOR

KENNETH R.
REESMAN
S-1351
BURLINGTON
WIS.
WIS.

North Line of POST ROAD

FIELD WORK BY KRR CJA

DRAWN BY KRR