

KOLB LAND CONSULTING, INC.
LAND SURVEYING • SUBDIVIDING • LAND PLANNING

929 WILLIAMS STREET

LAKE GENEVA, WISCONSIN 53147


414-248-3697



SCALE: 1" = 100'

LEGEND

σ - IRON PIPE FOUND

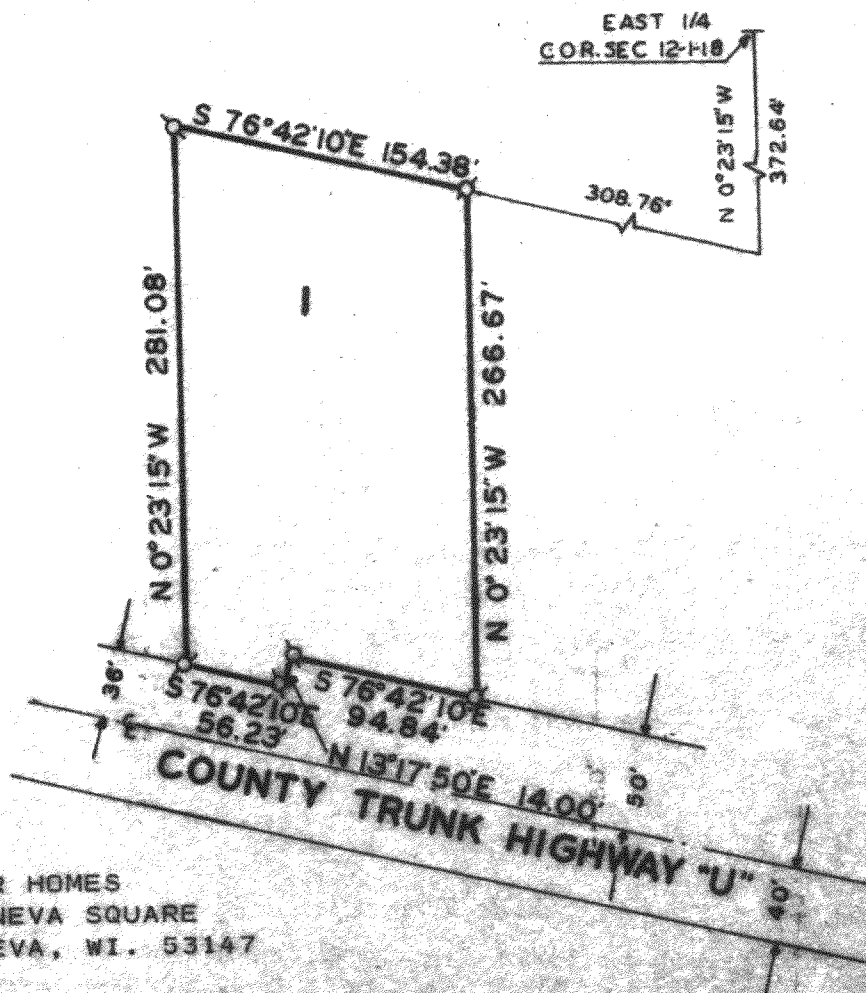


ORDERED BY: FIVE STAR HOMES
90 E. GENEVA SQUARE
LAKE GENEVA, WI. 53147

NOTE: THE EAST LINE OF SECTION 12-1-18 IS
ASSUMED N 0°23'15" W AS SHOWN ON
EXISTING SURVEY RECORDS.

PLAT OF SURVEY OF

LOT 1 OF CERTIFIED SURVEY MAP #474, AND LOCATED IN
THE NE 1/4 OF THE SE 1/4 OF SECTION 12, T1N, R18E,
TOWN OF BLOOMFIELD, WALWORTH COUNTY, WISCONSIN.

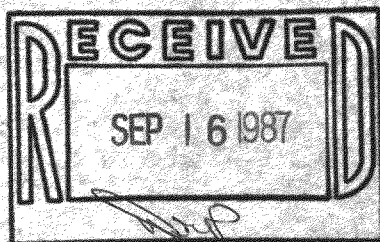

I, HAROLD H. KOLB, DO HEREBY CERTIFY THAT
I HAVE SURVEYED THE PROPERTY HEREON DES-
CRIBED ACCORDING TO THE OFFICIAL RECORDS,
AND THAT THE PLAT HEREON IS A CORRECT REP-
RESENTATION OF THE LOT LINES TO THE BEST
OF MY KNOWLEDGE AND BELIEF.

Harold H. Kolb

HAROLD H. KOLB

WISCONSIN REGISTERED LAND SURVEYOR, S-187

DATE AUGUST 19, 1985

REVISED _____

REVISED _____

MA474-1

KOLB LAND CONSULTING, INC.
LAND SURVEYING • SUBDIVIDING • LAND PLANNING

929 WILLIAMS STREET

LAKE GENEVA, WISCONSIN 53147


414-248-3697



SCALE: 1" = 100'

LEGEND

Ø - IRON PIPE FOUND

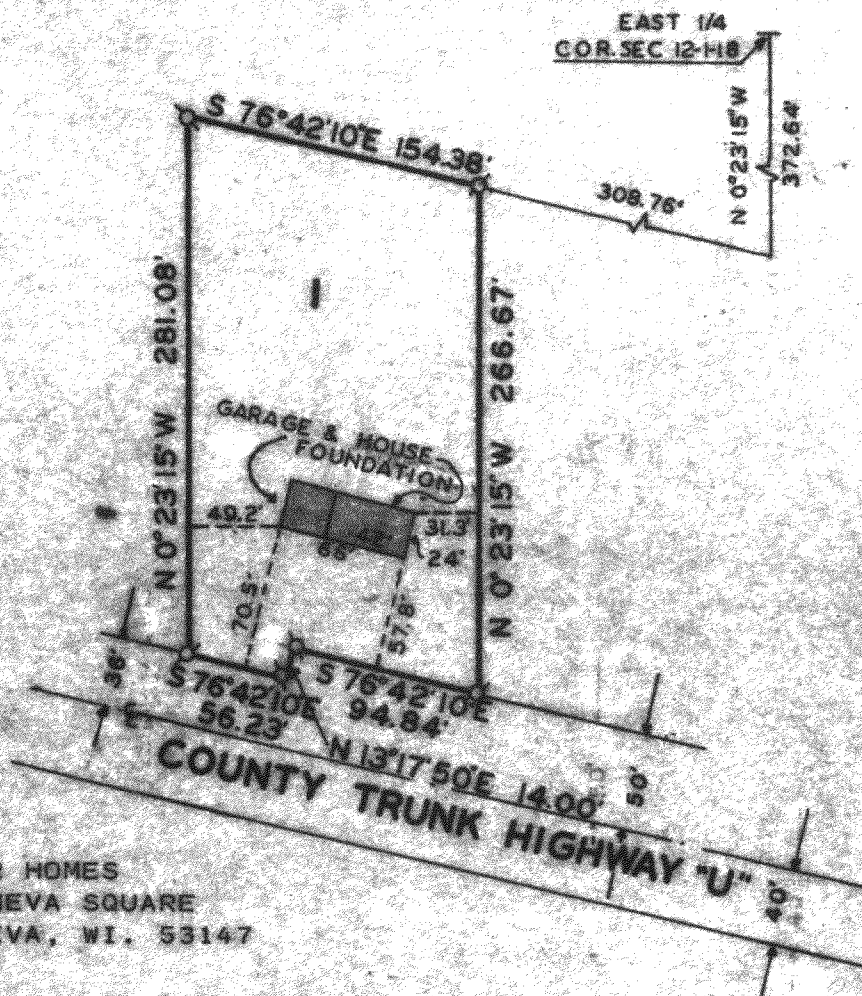



ORDERED BY: FIVE STAR HOMES
90 E. GENEVA SQUARE
LAKE GENEVA, WI. 53147

NOTE: THE EAST LINE OF SECTION 12-1-18 IS
ASSUMED N 0°23'15" W AS SHOWN ON
EXISTING SURVEY RECORDS.

PLAT OF SURVEY OF

LOT 1 OF CERTIFIED SURVEY MAP #474, AND LOCATED IN
THE NE 1/4 OF THE SE 1/4 OF SECTION 12, T1N, R18E,
TOWN OF BLOOMFIELD, WALWORTH COUNTY, WISCONSIN.

9-4-85: LOCATED HOUSE FOUNDATION. *H. Kolb*

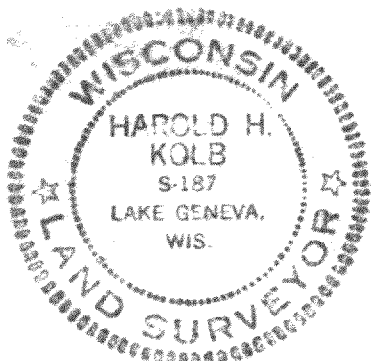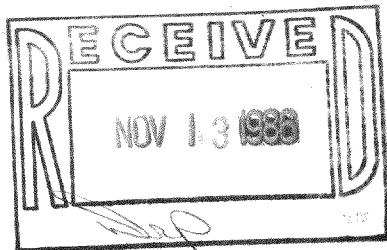

I, HAROLD H. KOLB, DO HEREBY CERTIFY THAT
I HAVE SURVEYED THE PROPERTY HEREON DES-
CRIBED ACCORDING TO THE OFFICIAL RECORDS,
AND THAT THE PLAT HEREON IS A CORRECT REP-
RESENTATION OF THE LOT LINES TO THE BEST
OF MY KNOWLEDGE AND BELIEF.

Harold H. Kolb

HAROLD H. KOLB

WISCONSIN REGISTERED LAND SURVEYOR, S-187

DATE AUGUST 19, 1985

REVISED SEPT. 4, 1985

REVISED