


DUNHAM SURVEYING, S.C.
SURVEYING & SUBDIVIDING
DELAVER, WISCONSIN 53115

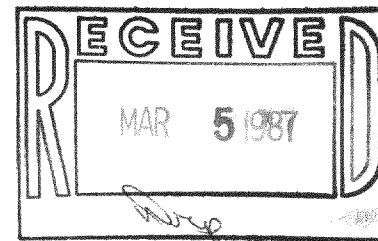

Scale - 1" = 20'
● = 3/4" Dia. Iron Pipe Found
○ = 1" Dia. Iron Pipe Found
⊗ = 1/2"x24" Iron Pipe Set
⊠ = 1"x24" Iron Pipe Set
(80) = Recorded Distance

Bearings are referenced to the
South line of Florence Road,
assumed bearing of East.
Owners: John Strauss
8110 Latrobe
Burbank, Ill. 60459

STATE OF WISCONSIN) SS
COUNTY OF WALWORTH)

I, George T. Dunham, Surveyor, certify that I have surveyed
the property described as follows,
Lots 3688 through 3691, inclusive, Block 76 of Section 3 of
Pell Lake Subdivision, located in Section 15, T1N, R18E,
Walworth County, Wisconsin,
and that the map shown above is a true representation thereof and
shows the size and location of the property, its exterior boundaries,
the location of all visible structures and dimensions of all principal
buildings thereon, boundary fences, apparent easements, roadways and
visible encroachments, if any, and that I have surveyed the property
hereon described according to the official records, to the best of
my knowledge and belief.
August 28, 1986.

George T. Dunham
George T. Dunham, Surveyor

