

PLAT OF SURVEY
OF



LOTS 28 & 29, NIPPERSINK HIGHLANDS, LOCATED IN THE NE 1/4 OF THE NE 1/4 AND IN THE NW 1/4 OF THE NE 1/4 OF SECTION 24, T. 1 N., R. 18 E. OF THE TOWN OF BLOOMFIELD, COUNTY OF WALWORTH, STATE OF WISCONSIN.

FOR: KEITH JOHNSON REALTY WORLD

SCALE 1" = 40'

o = IRON PIPE FOUND.

BEARING DATUM IS THAT OF RECORDED PLAT.

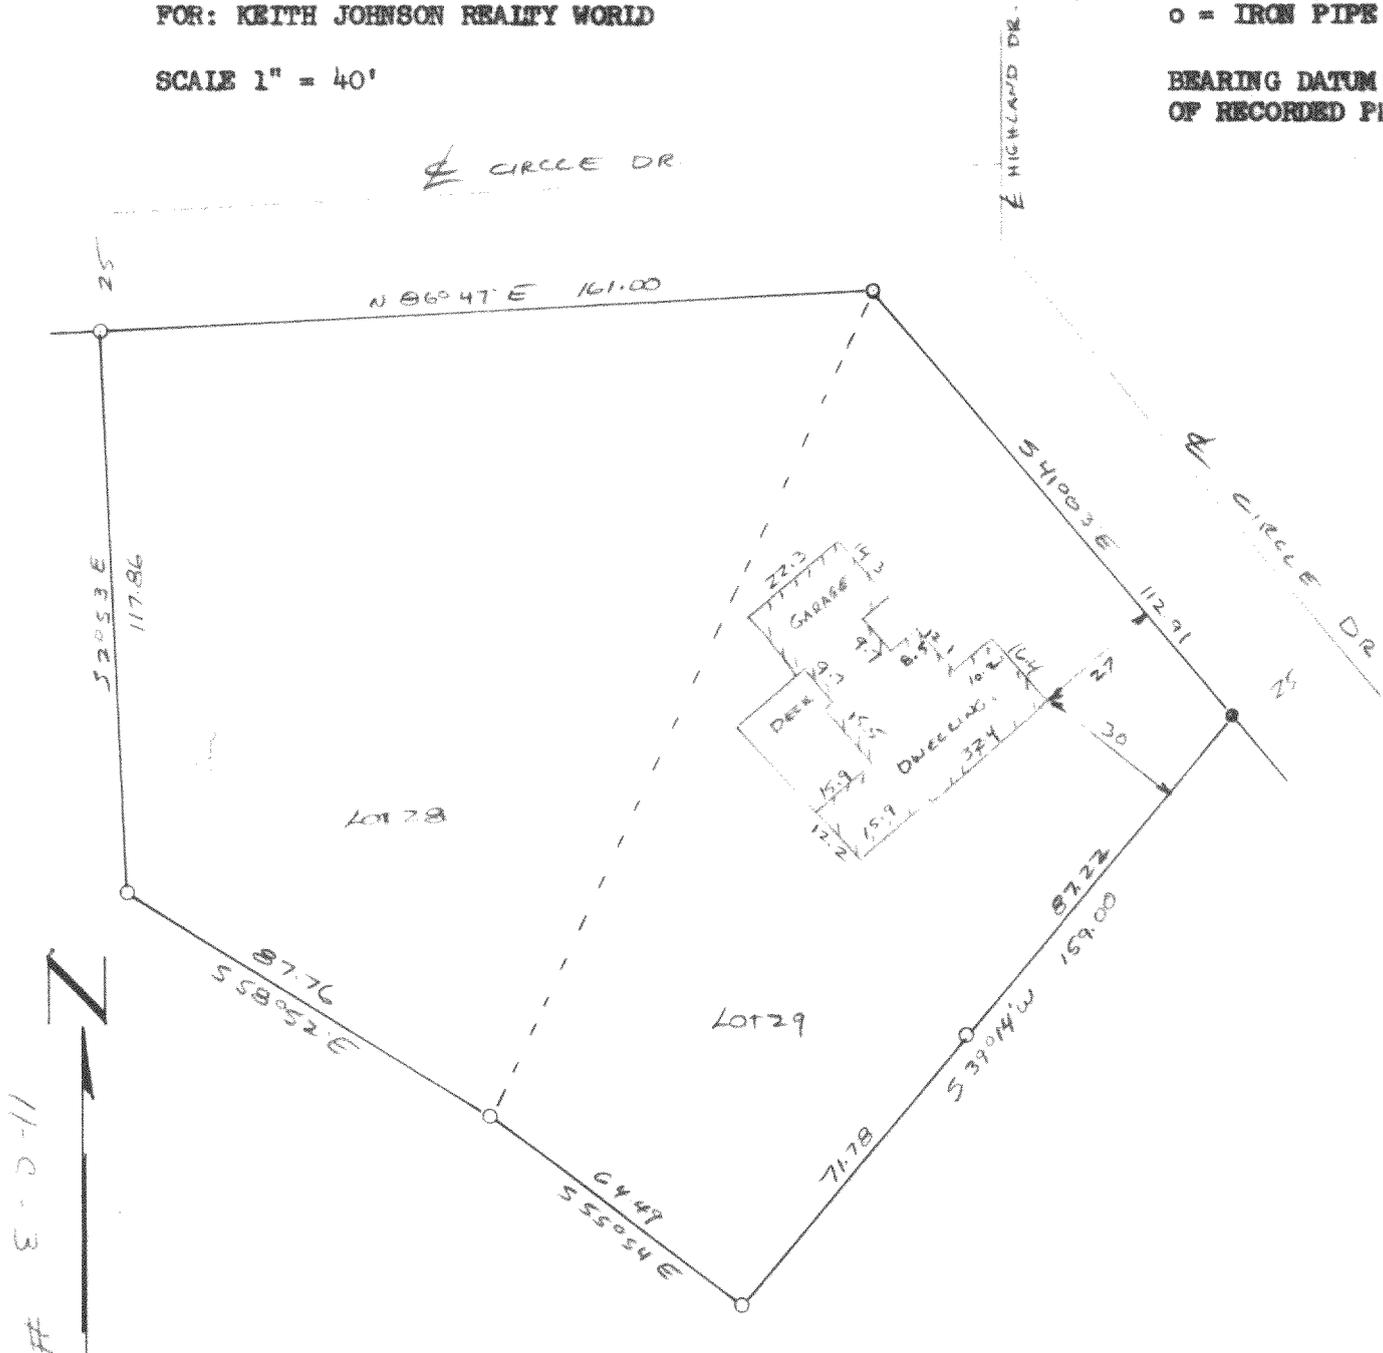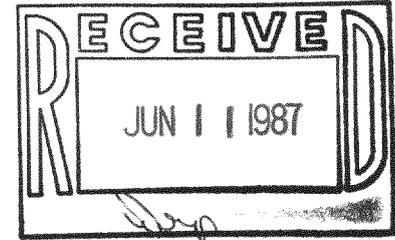

I have surveyed the above-described property, and the map hereon is a true representation thereof and shows the site and location of the property, its exterior boundaries, the location and dimensions of all visible structures thereon, fences, apparent easements and roadways and visible encroachments, if any.

This survey is made for the exclusive use of the present owners of the property, and also those who purchase, mortgage, or guarantee the title thereto, within one year from date hereof.

Dated at Burlington, this 19th day of May, 1987
 John F. Degan
 John F. Degan, Head Surveyor & S&L

11-C-3 #449

2 MAY 28 1987

118-736