




WALWORTH COUNTY
SURVEYING & MAPPING
LAKE GENEVA, WISCONSIN

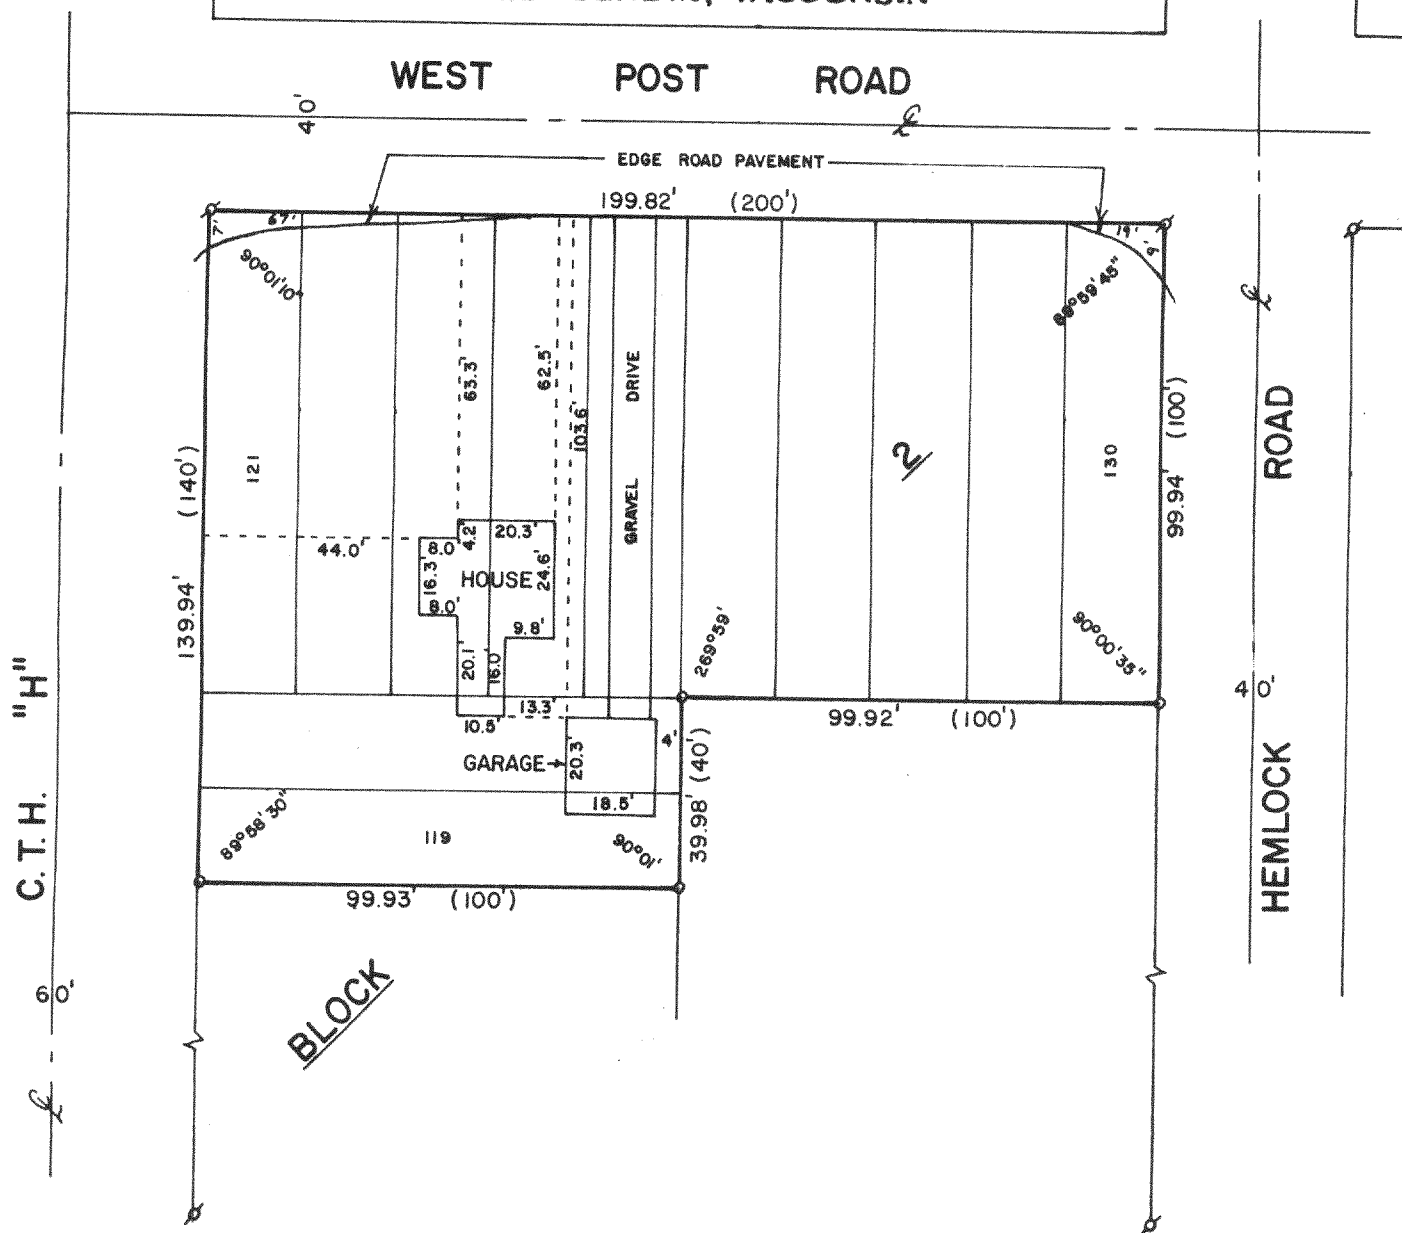

PLAT OF SURVEY OF

LOTS 119-130, BLOCK 2, PELL LAKE SUBDIVISION,
SECTION 1, T1N, R18E, WALWORTH COUNTY, WISCONSIN.

ORDERED BY: KAVANAUGH REALTY
LAKE GENEVA, WI. 53147

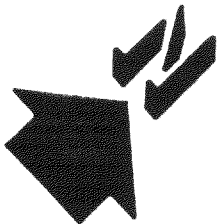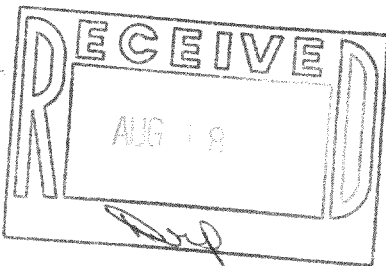

SCALE - 1"=40'

LEGEND

- ⊕ - IRON PIPE FOUND
- - IRON ROD SET
- () - RECORDED AS

I, ROBERT M. BAERENWALD, DO HEREBY CERTIFY THAT I
HAVE SURVEYED THE PROPERTY HEREON DESCRIBED ACCORDING
TO THE OFFICIAL RECORDS AND THAT THE PLAT HEREON IS A
CORRECT REPRESENTATION OF THE PROPERTY LINES TO THE
BEST OF MY KNOWLEDGE AND BELIEF.

Robert M. Baerenwald
ROBERT M. BAERENWALD
WISCONSIN REGISTERED LAND SURVEYOR, S-1508

DATE *July 17, 1987*
JOB NO. 1164

NOTE: THIS IS NOT A CERTIFIED COPY UNLESS SEALED.