



WALWORTH COUNTY
SURVEYING & MAPPING
LAKE GENEVA, WISCONSIN

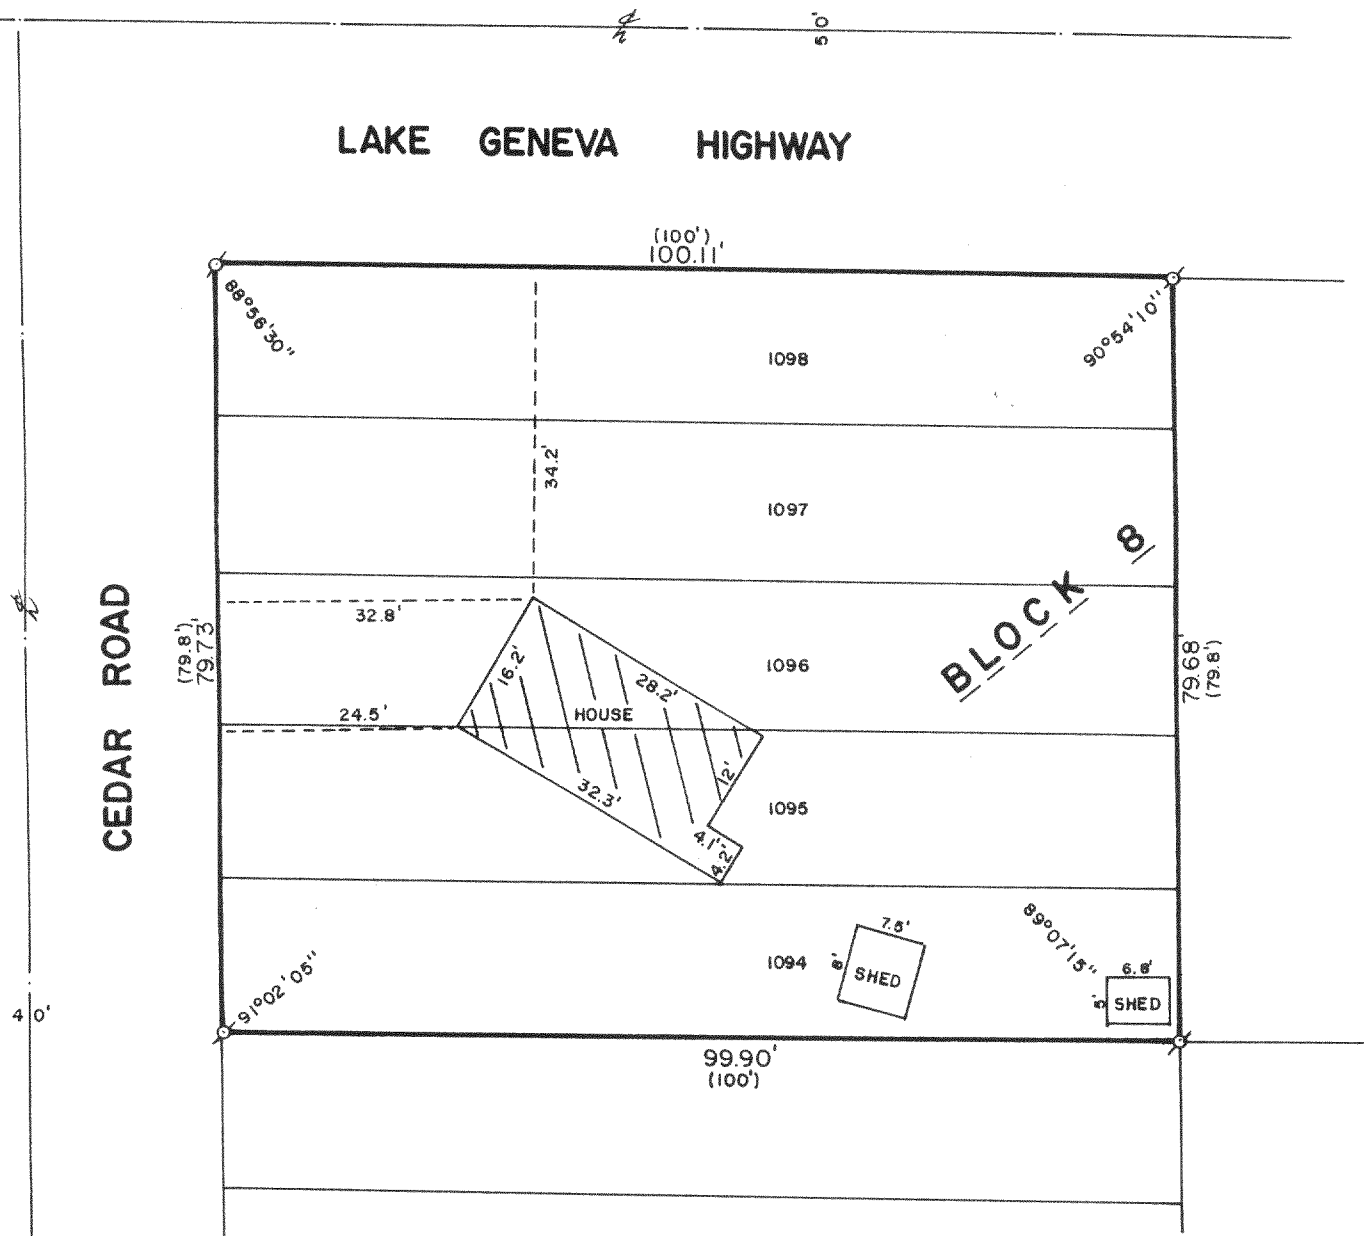


PLAT OF SURVEY OF

LOTS 1094-1098, BLOCK 8 OF PELL
LAKE HIGHLANDS, LOCATED IN SECTION
16, T 1 N, E 18 E, WALWORTH COUNTY,
WISCONSIN.

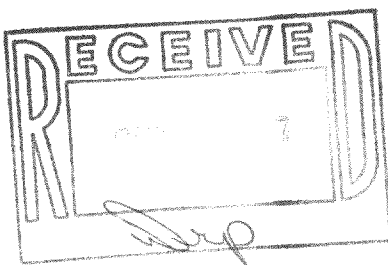

ORDERED BY: COLDWELL BANKER
GENEVA LAKES AREA REALTORS
838 MAIN STREET
LAKE GENEVA, WISCONSIN
53147

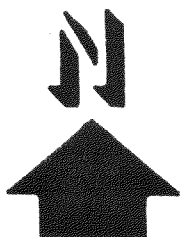

SCALE: 1"=50'

σ - IRON PIN POINT
() - RECORDED AS

I, ROBERT M. BAERENWALD, DO HEREBY CERTIFY THAT I
HAVE SURVEYED THE PROPERTY HEREON DESCRIBED ACCORDING
TO THE OFFICIAL RECORDS AND THAT THE PLAT HEREON IS A
CORRECT REPRESENTATION OF THE PROPERTY LINES TO THE
BEST OF MY KNOWLEDGE AND BELIEF.

Robert M. Baerenwald
ROBERT M. BAERENWALD
WISCONSIN REGISTERED LAND SURVEYOR, S-1508

Sept. 16, 1987
DATE JOB NO. 1250

NOTE: THIS IS NOT A CERTIFIED COPY UNLESS SEALED.