

JUNEAU ROAD

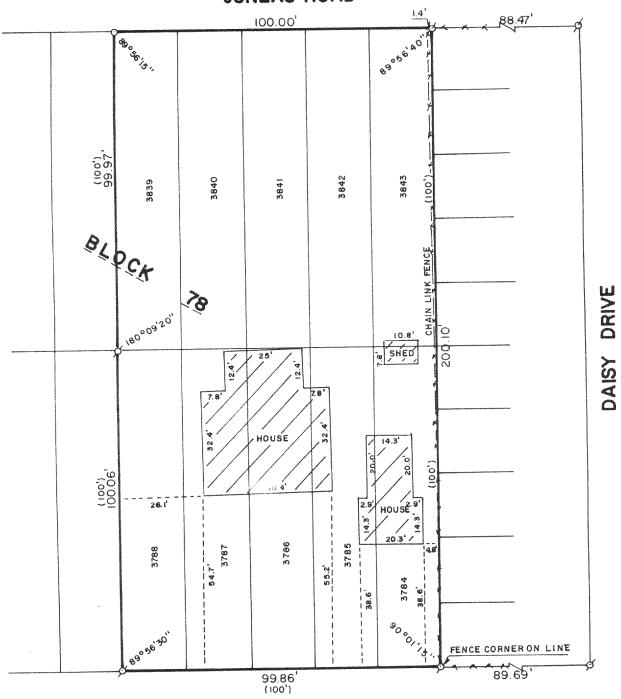

GREEN ROAD

PLAT OF SURVEY OF

LOTS 3784-3788 AND 3839-3843, BLOCK 78 OF SECTION 3 OF PELL LAKE SUBDIVISION, LOCATED IN T 1 N, R 18 E, WALWORTH COUNTY, WISCONSIN.

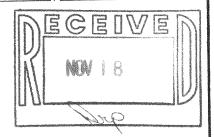

ORDERED BY: JOHN PALKA, JR. P. O. BOX 526

PELL LAKE, WISCONSIN 53157



SCALE: 1"=30'

ø -IRON PIPE FOUND o - IRON ROD PLACED

()-RECORDED AS

I, ROBERT M. BAERENWALD, DO HEREBY CERTIFY THAT I HAVE SURVEYED THE PROPERTY HEREON DESCRIBED ACCORDING TO THE OFFICIAL RECORDS AND THAT THE PLAT HEREON IS A CORRECT REPRESENTATION OF THE PROPERTY LINES TO THE BEST OF MY KNOWLEDGE AND BELIEF.

ROBERT M. BAERENWALD

WISCONSIN REGISTERED LAND SURVEYOR, S-1508

DATE JOB NO. 1316 THIS IS NOT A CERTIFIED COPY UNLESS SEALED. NOTE: