


929 WILLIAMS STREET LAKE GENEVA, WISCONSIN 53147 414-248-3697

HEMLOCK ROAD 40' WIDE

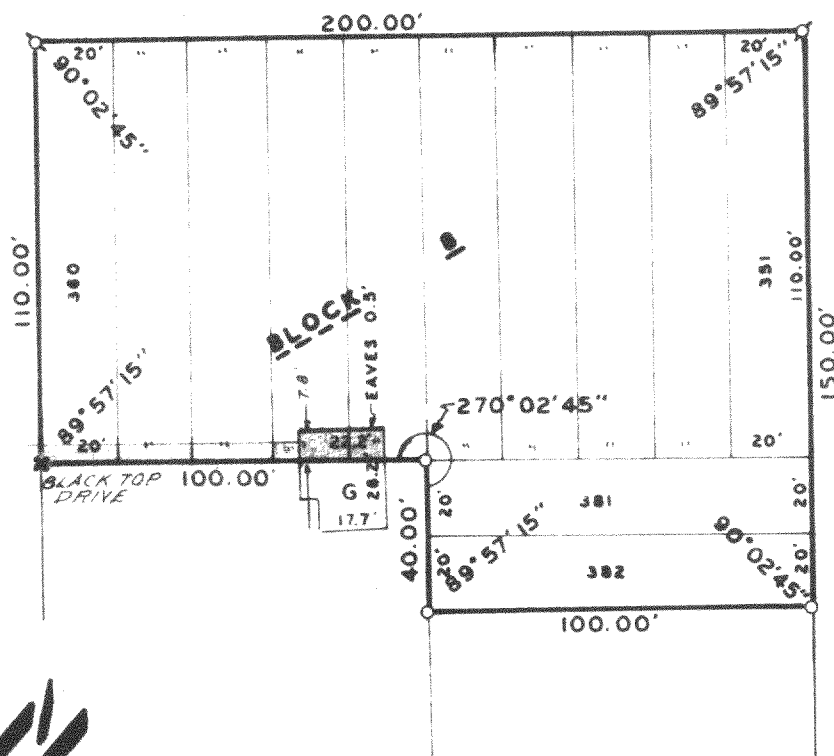


WALNUT ROAD 40' WIDE

SCALE: 1" = 50'

OWNER: ROMAN BULKIEWICZ JR.

Ø - IRON PIPE FOUND
O - 1" X 24" IRON PIPE SET
() - AS RECORDED
G - GARAGE
X - RR SPIKE SET

LOTS 351-60 AND 381-82, BLOCK 3, OF THE
PELL LAKE SUBDIVISION, TOWN OF BLOOMFIELD,
WALWORTH COUNTY, WISCONSIN.

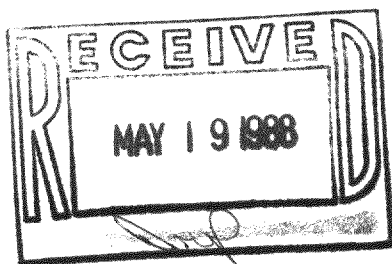

I, HAROLD H. KOLB, DO HEREBY CERTIFY THAT I HAVE SURVEYED THE PROPERTY HEREON DESCRIBED ACCORDING TO THE OFFICIAL RECORDS AND THAT THE PLAT HEREON IS A CORRECT REPRESENTATION OF THE LOT LINES AND THE PRINCIPAL LINES OF THE BUILDING THEREON, TO THE BEST OF MY KNOWLEDGE AND BELIEF. SURVEY NOT VALID UNLESS SURVEYOR'S SIGNATURE IS IN RED.

HAROLD H. KOLB
WISCONSIN REGISTERED LAND SURVEYOR, S-197
DATE NOVEMBER 6, 1986
REVISED JANUARY 30, 1987
REVISED _____