
WALWORTH COUNTY SURVEYING & MAPPING LAKE GENEVA, WISCONSIN

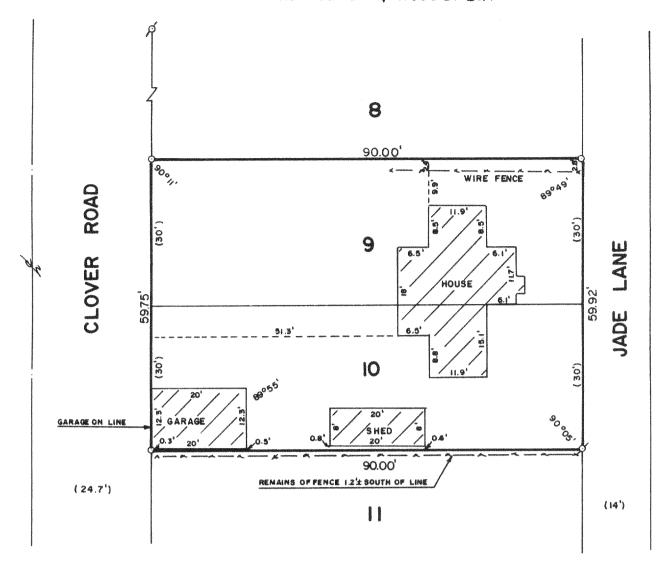


PLAT OF SURVEY OF

LOTS 9 AND 10 OF SITTERLE'S SUBDIVISION, LOCATED IN T 1 N, R 18 E, WALWORTH COUNTY, WISCONSIN.

ORDERED BY: REALTY WORLD-TAGGART LAKE GENEVA, WISCONSIN

NOTE: EAVES ON GARAGE EXTEND OVER LOT LINE 0.7 FEET+.

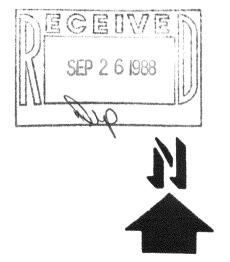

SCALE: 1"=20'

ø-IRON PIPE FOUND o-IRON ROD PLACED ()-RECORDED AS I HEREBY CERTIFY THAT I HAVE SURVEYED THE ABOVE DESCRIBED PROPERTY AND THAT THE ABOVE MAP IS A TRUE REPRESENTATION THEREOF AND SHOWS THE SIZE AND LOCATION OF THE PROPERTY, ITS EXTERIOR BOUNDARIES, THE LOCATION OF ALL VISIBLE STRUCTURES AND DIMENSIONS OF ALL PRINCIPAL BUILDINGS THEREON, BOUNDARY FENCES, APPARENT EASEMENTS AND ROADWAYS AND VISIBLE ENCROACHMENTS, IF ANY.

THIS SUFFVEY IS MADE FOR THE EXCLUSIVE USE OF THE PRESENT OWNERS OF THE PROPERTY, AND ALSO THOSE WHO PURCHASE, MORTGAGE, OR GUARANTEE THE TITLE THERETO WITHIN ONE (1) YEAR FROM DATE HEREOF.

ROBERT M. BAERENWALD

WISCONSIN REGISTERED LAND SURVEYOR, S-1508

DATE JOB NO. 1652

NOTE: THIS IS NOT A CERTIFIED COPY UNLESS SEALED.

M5-5