
## WALWORTH COUNTY SURVEYING & MAPPING LAKE GENEVA, WISCONSIN

## ABANDONED RAILROAD R. O. W.

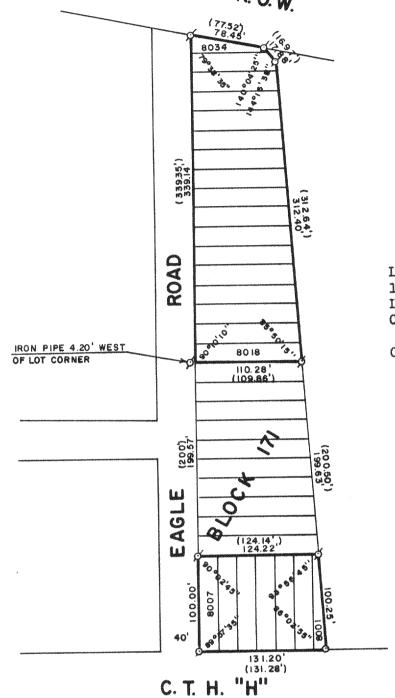


PLAT OF SURVEY OF

LOTS 8001-8007 AND 8018-8034, BLOCK 171 OF SECTION 5 OF PELL LAKE SUB., LOCATED IN T 1 N, R 18 E, WALWORTH COUNTY, WISCONSIN.

ORDERED BY: ANTHONY PYTKO

6015 SOUTH NATOMA AVENUE

CHICAGO, ILLINOIS 60638

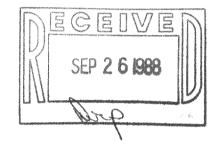



SCALE: 1"=100'

g -IRON PIPE FOUND
o -IRON ROD PLACED

()-RECORDED AS

I HEREBY CERTIFY THAT I HAVE SURVEYED THE ABOVE DESCRIBED PROPERTY AND THAT THE ABOVE MAP IS A TRUE REPRESENTATION THEREOF AND SHOWS THE SIZE AND LOCATION OF THE PROPERTY, ITS EXTERIOR BOUNDARIES, THE LOCATION OF ALL VISIBLE STRUCTURES AND DIMENSIONS OF ALL PRINCIPAL BUILDINGS THEREON, BOUNDARY FENCES, APPARENT EASEMENTS AND ROADWAYS AND VISIBLE ENCROACHMENTS, IF ANY.

THIS SURVEY IS MADE FOR THE EXCLUSIVE USE OF THE PRESENT OWNERS OF THE PROPERTY, AND ALSO THOSE WHO PURCHASE, MORTGAGE, OR GUARANTEE THE TITLE THERETO WITHIN ONE (I) YEAR FROM DATE HEREOF.

ROBERT M. BAERENWALD

WISCONSIN REGISTERED LAND SURVEYOR, S-1508

DATE JOB NO. 1411

NOTE: THIS IS NOT A CERTIFIED COPY UNLESS SEALED.

MPL-1622, 1625, 1625, 1625