

WALWORTH COUNTY SURVEYING & MAPPING LAKE GENEVA, WISCONSIN

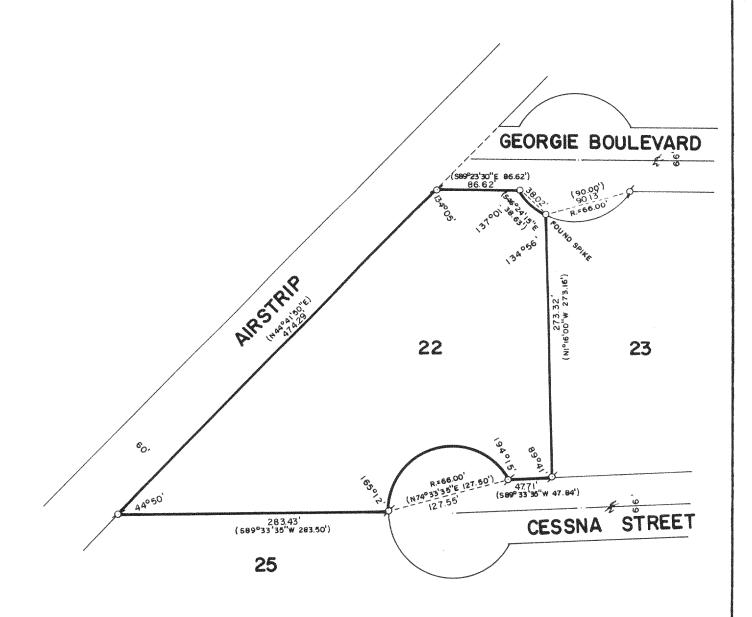

PLAT OF SURVEY OF

LOT 22 OF THE FIRST ADDITION TO LAKE GENEVA AIRE ESTATES, A SUBDIVISION LOCATED IN SECTIONS 3 AND 4, T 1 N, R 18 E, WALWORTH COUNTY, WISCONSIN.

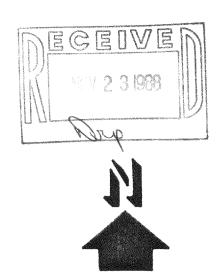

SCALE: 1"=100'

ORDERED BY: REALTY WORLD-TAGGART

736 MAIN STREET LAKE GENEVA, WISCONSIN 53147

THEREBY CERTIFY THAT THAVE SURVEYED THE ABOVE DESCRIBED PROPERTY AND THAT THE ABOVE MAP 18 A TRUE REPRESENTATION THEREOF AND 8HOWS THE SIZE AND LOCATION OF THE PROPERTY, ITS EXTERIOR BOUNDARIES, THE LOCATION OF ALL VISIBLE STRUCTURES AND DIMENSIONS OF ALL PRINCIPAL BUILDINGS THEREON, BOUNDARY FENCES, APPARENT EASEMENTS AND ROADWAYS AND VISIBLE ENCROACHMENTS, IF ANY.

THIS SURVEY IS MADE FOR THE EXCLUSIVE USE OF THE PRESENT OWNERS OF THE PROPERTY, AND ALSO THOSE WHO PURCHASE, MORTGAGE, OR GUARANTEE THE TITLE THERETO WITHIN ONE (1) YEAR FROM DATE HEREOF.

ROBERT M. BAERENWALD

WISCONSIN REGISTERED LAND SURVEYOR, S-1508

DATE

JOB NO. 1764

NOTE: THIS IS NOT A CERTIFIED COPY UNLESS SEALED.