LOTS NUMBERED 8 AND 9, BLOCK 3, PART 1 OF FIRST ADDITION TO JEFFERSON ISLAND SUBDIVISION, A PART OF THE SOUTHEAST 1/4 OF SECTION 13, IN TOWN 1 NORTH OF RANGE 18 EAST OF THE FOURTH PRINCIPAL MERIDIAN, TOWN OF BLOOMFIELD, WALWORTH COUNTY, WISCONSIN.


FOR: COMMELIA AND SHROUD

SCALE 1" = 40'

ø = IRON PIPE STAKE FOUND

• = CONCRETE MONUMENT FOUND.

BEARING DATUM IS THAT OF RECORDED PLAT.

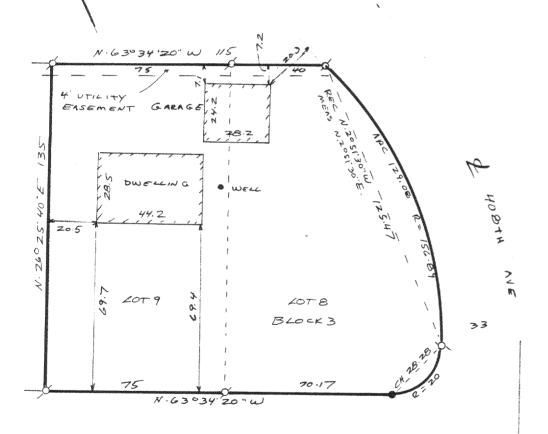

NOV 15 1989

I have surveyed the above-described property, and the map hereon is a true representation thereof and shows the size and location of the property, its exterior boundaries, the location and dimensions of all visible structures thereon, fences, apparent easements and roadways and visible encroachments, if any.

This survey is made for the exclusive use of the present owners of the property, and also those who purchase, mortgage, or guarantee the title thereto, within one year from date hereof,

of	pated at Burlington, this 6+H.	_ day
(	John F. Degen, Land Surveyor S 242 589 N. Pine St. Burlington, WI 53105	THE PERSON NAMED IN

& POWERS LAKE RD

MJ15-25