



Plat of Survey

of

Lots 9073 thru 9083, Block 156, Pell Lake Subdivision, located in
Section 22, Town 1 North, Range 18 East, Town of Bloomfield,
Walworth County, Wisconsin.

Surveyed for: Charlotte O'Conner
P.O. Box 189
Pell Lake Wisconsin. 53157

Bearings referenced to the Subdivision Plat

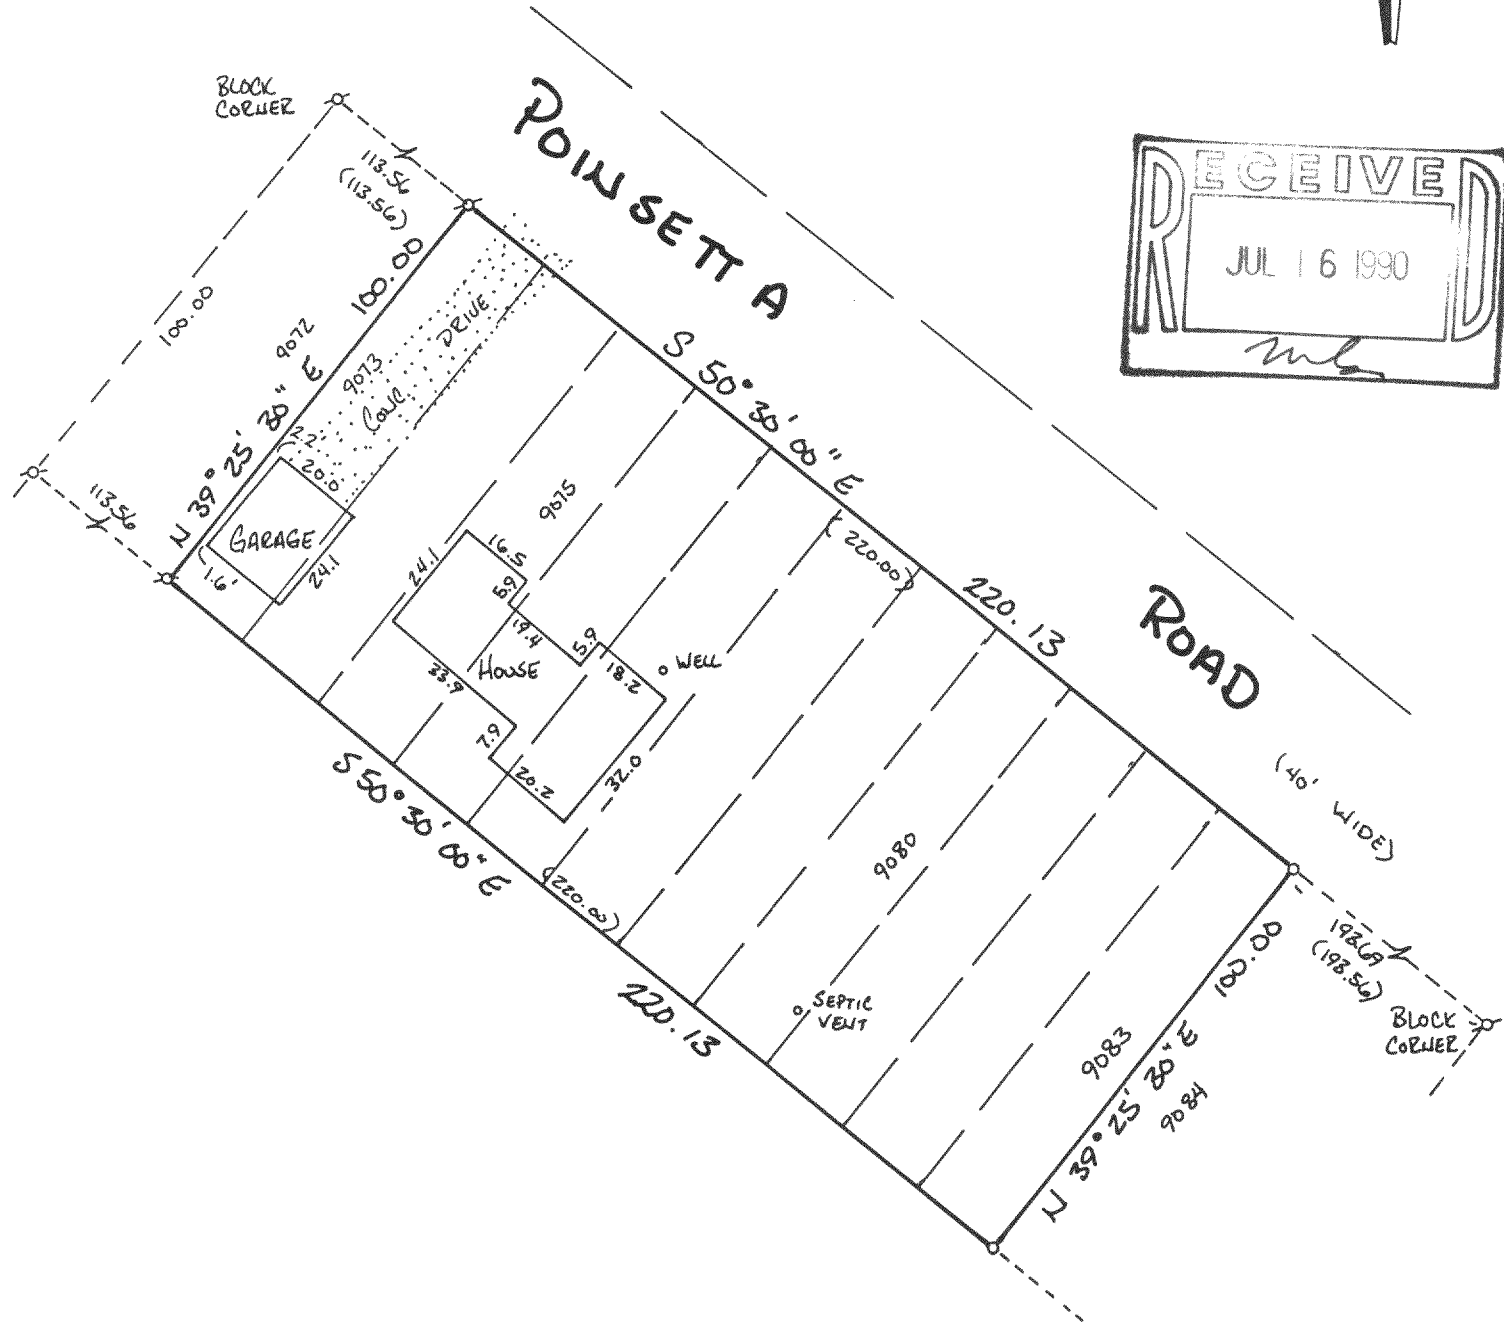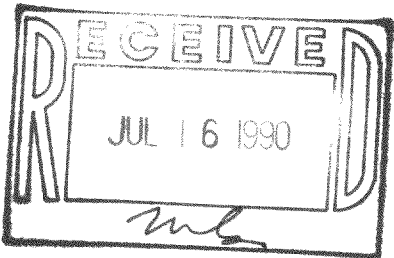

Copyright © 1989 by Jensen Surveying & Mapping S.C.
All rights reserved. No part of this survey plat may be reproduced or transmitted in any form
by any means - graphic, electronic, or mechanical, including photocopying, tracing, or infor-
mation storage and retrieval systems - without permission in writing from Thomas P.A. Jensen.

I, Thomas P.A. Jensen, Wisconsin Registered Land Surveyor, do hereby certify that this
survey was performed by me, or under my direction, in full compliance with the owner's/agent's
instructions and Chapter A-E 7 of the Wisconsin Administrative Code ' Minimum Standards For
Property Surveys ', and that this map is an accurate representation thereof to the best of my
knowledge and belief.

Note: This survey plat is not
certified unless signed
and sealed in red ink.

118-914
Thomas P.A. Jensen R.L.S. 1084

Legend

- ⊗ ~ Found iron pipe
- ~ Set iron pipe
- () ~ Recorded as dimension

Jensen Surveying & Mapping S.C.

45 South Wisconsin Street P.O. Box 322
Elkhorn, Wisconsin. 53121.
(414) 723-3434

Scale: 1 = 40'



Mapping date: May 31, 1989

Revisions: _____

Sheet 1 of 1 Sheets

Job reference number:
1989.060

Tax # MPL-1834