326 NORTH PINE STREET / BURLINGTON, WI 53105 / 414/763-7834 FAX/ 414/763-2509

Baxter Woodman of Wisconsin

PLAT OF SURVEY FOR WALTER GONSIOR


118-918


FIELD WORK BY Fla & bjz DRAWN BY bjz

90206

JOB NUMBER

Lots 721, 722, 723, 724, 725, 726, Block 15, Pell Lake Subdivision, Section 1, Town 1 North, Range 18 East, Town of Bloomfield, Walworth County, Wisconsin.

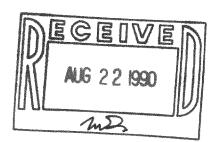

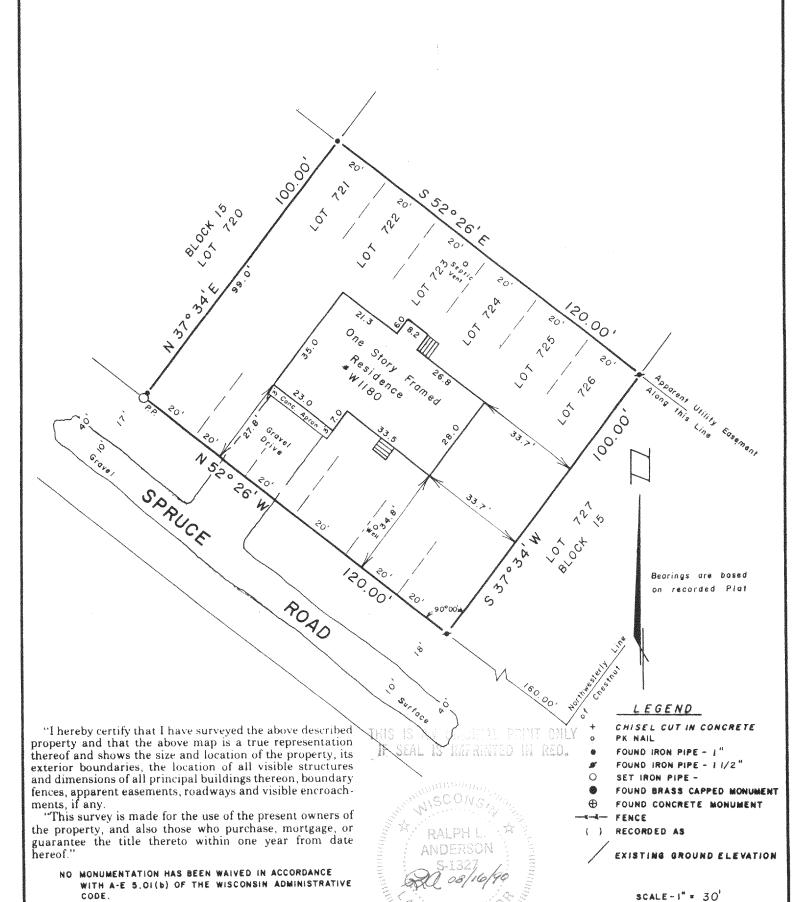

8/16/90

DATE

SURVEYOR # 1327