

## WAL WOR TH COUNTY SUR VEYING & MAPPING 727 HENRY STREET LAKE GENEVA, WISCONSIN 414-248-0505

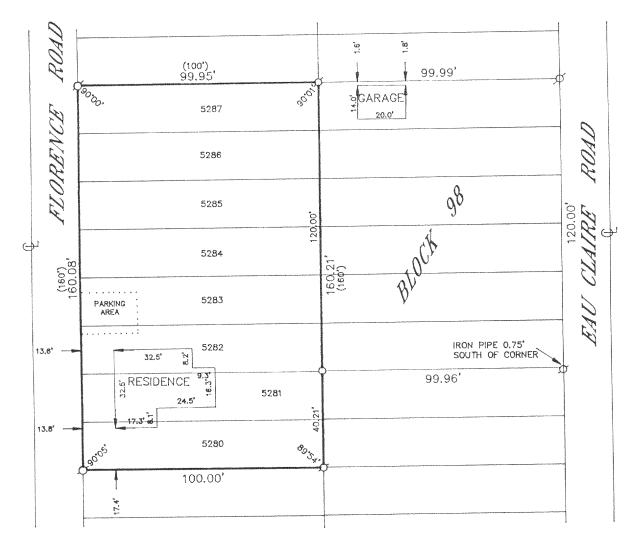

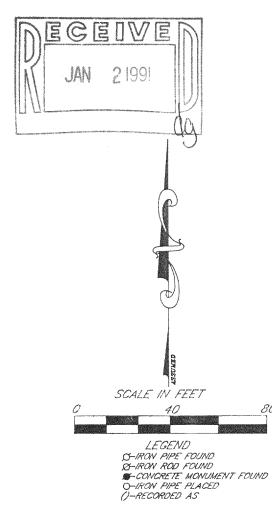

PLAT OF SURVEY OF

LOTS 5280-5287, BLOCK 98 OF SECTION 3 OF PELL LAKE SUBDIVISION, LOCATED IN T 1 N, R 18 E, WALWORTH COUNTY, WISCONSIN.

ORDERED BY: CENTURY 21 GENEVA LAKE

503 CENTER STREET LAKE GENEVA, WISCONSIN

I HEREBY CERTIFY THAT I HAVE SURVEYED THE ABOVE DESCRIBED PROPERTY AND THAT THE ABOVE MAP IS A TRUE REPRESENTATION THEREOF AND SHOWS THE SIZE AND LOCATION OF THE PROPERTY, ITS EXTERIOR BOUNDARIES, THE LOCATION OF ALL VISIBLE STRUCTURES AND DIMENSIONS OF ALL PRINCIPAL BUILDINGS THEREON, BOUNDARY FENCES, APPARENT EASEMENTS, ROADWAYS AND VISIBLE ENCROACHMENTS, IF ANY, TO THE BEST OF MY KNOWLEDGE AND BELIEF.

THIS SURVEY IS MADE FOR THE USE OF THE PRESENT OWNERS OF THE PROPERTY AND ALSO THOSE WHO PURCHASE, MORTGAGE OR CUARANTEE THE TITLE THERETO MITHIN ONE (1) YEAR FROM DATE HEREOF,

ROBERT M. BALLANDER
WSCONSIN REGISTERED LAND SURVEYOR, S-1508

DATE FULL / JOB NO. 2344

NOTE: THIS IS NOT A CERTIFIED COPY UNLESS SEALED.

Survey#118-925

TAX KEY#MPL \$1137