


DUNHAM SURVEYING, S.C.
SURVEYING & SUBDIVIDING
DELAVER, WISCONSIN 53115

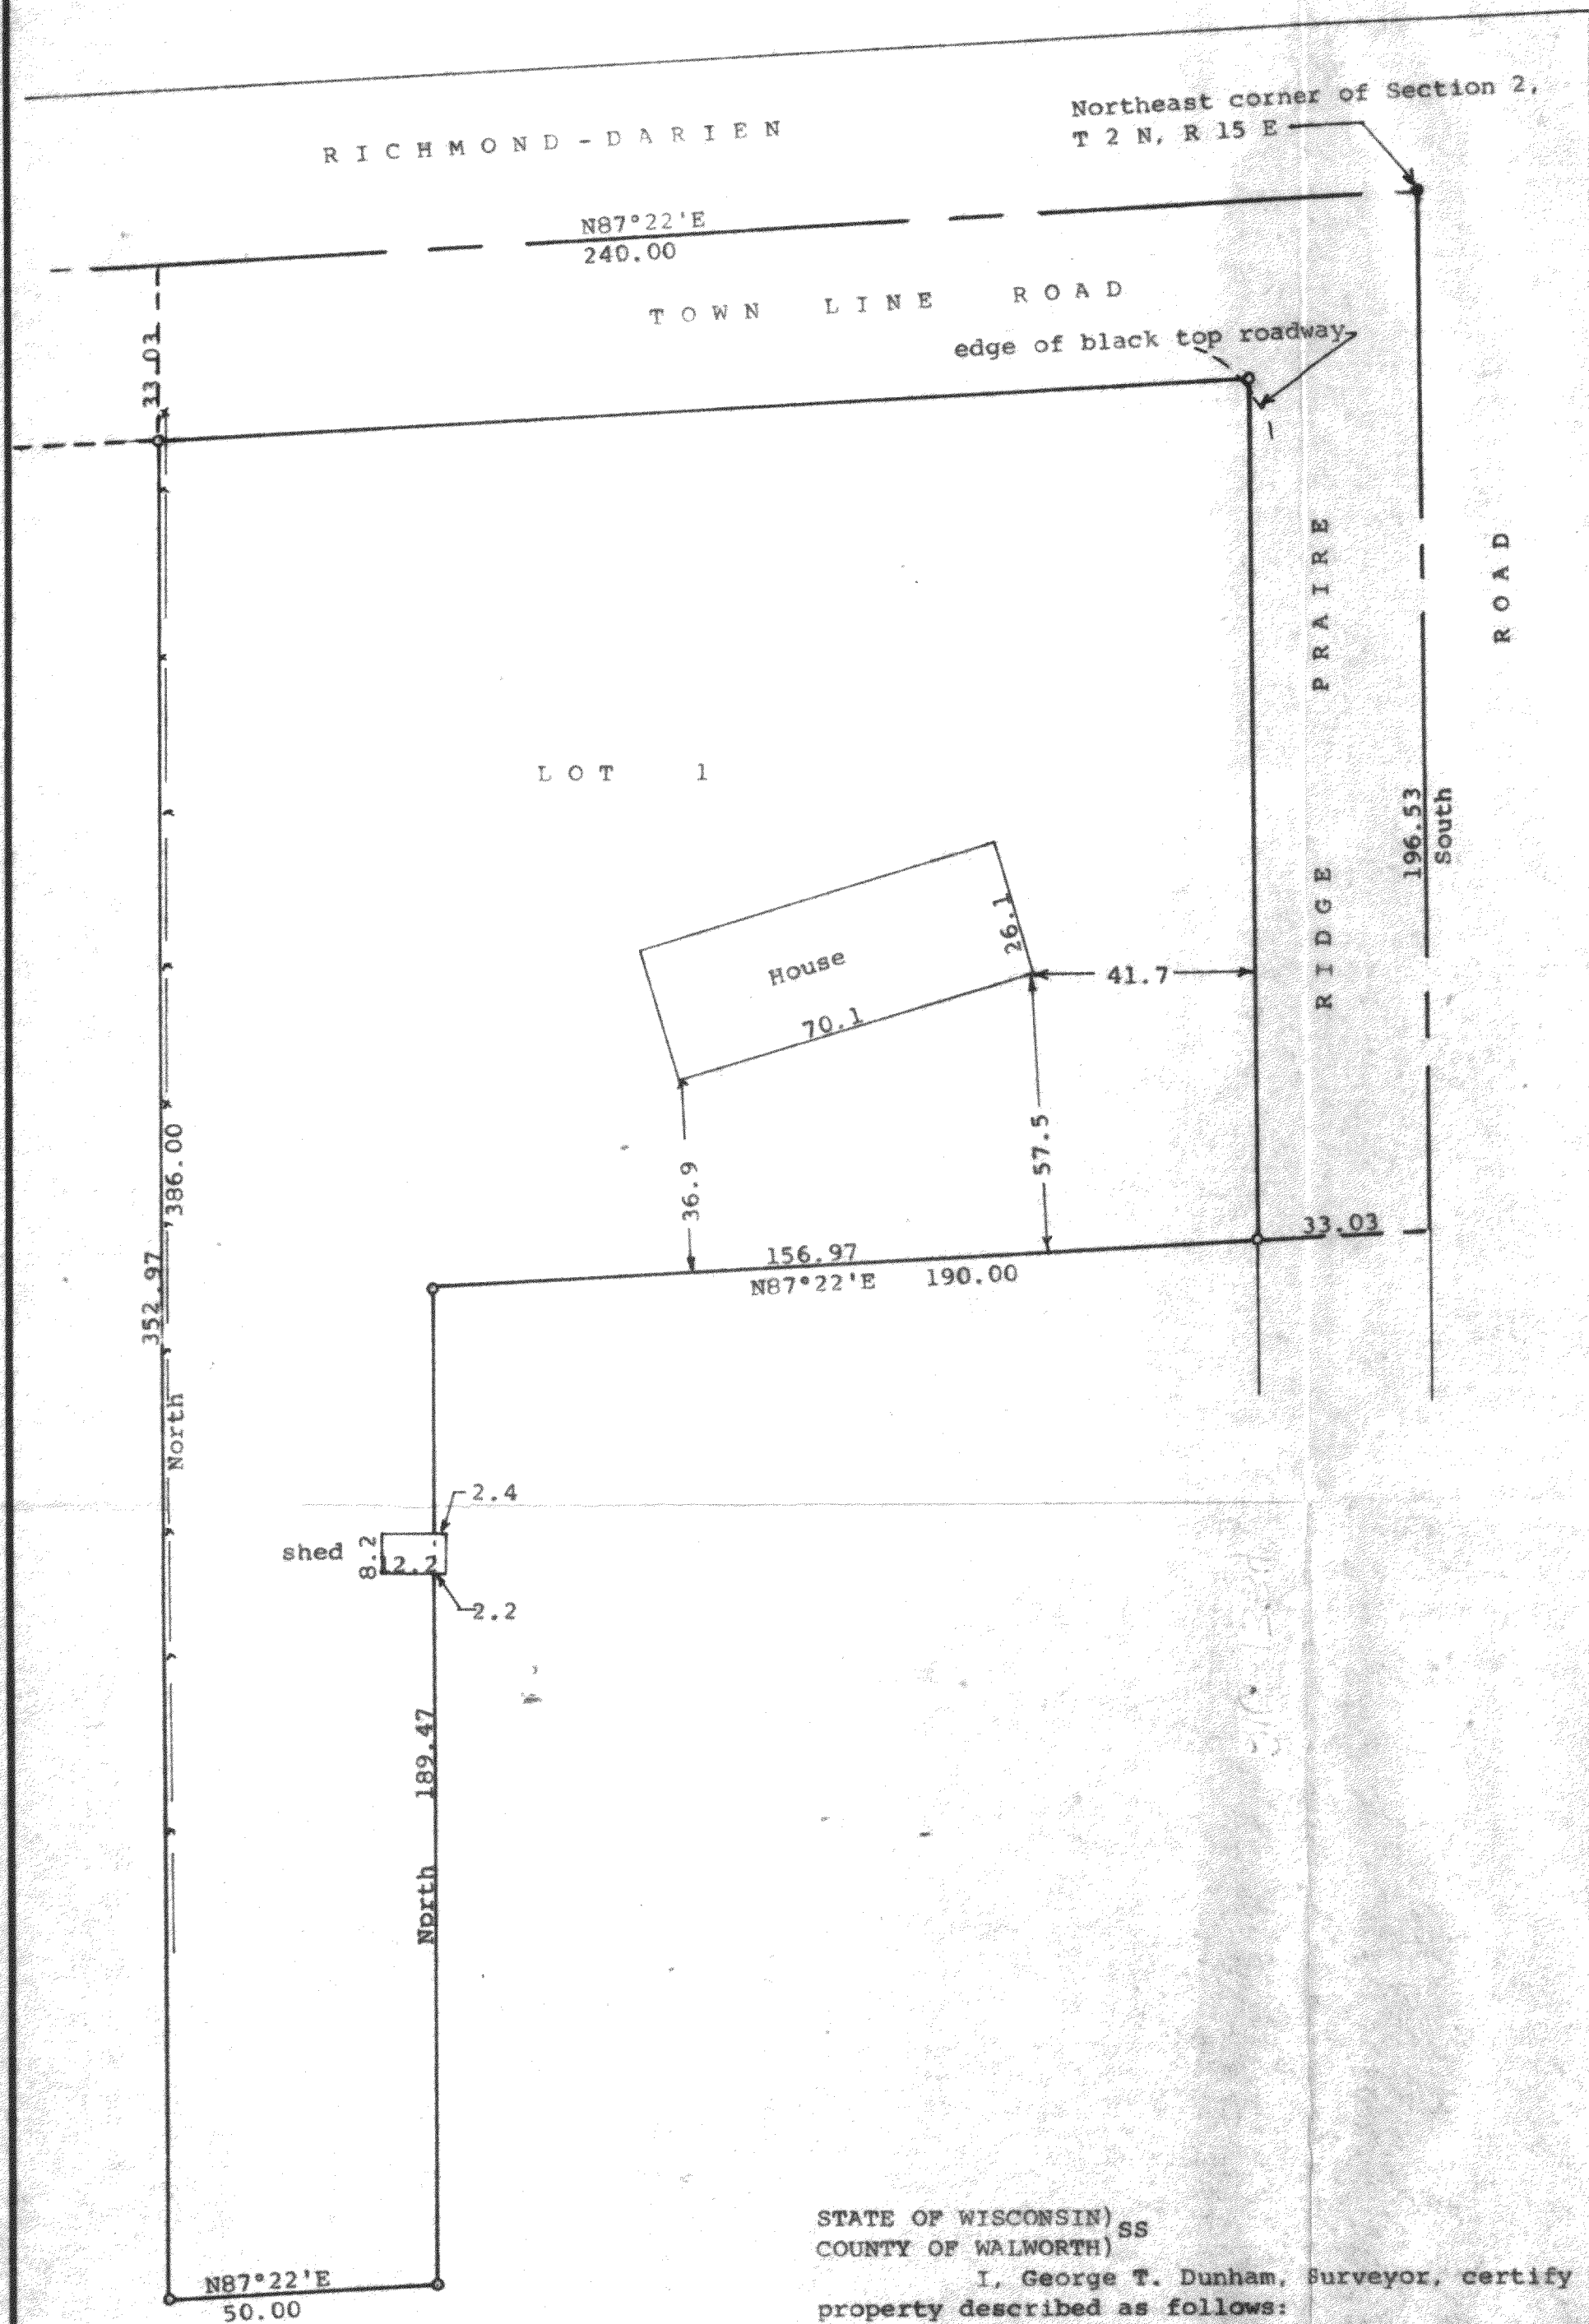

N

Scale - 1" = 30'

○ = 1" Iron Pipe Found

● = Concrete Monument Found

--- = Fence Line

Bearings referenced to the assumed bearing of South along the east line of Section 2, T 2 N R 15 E

Survey ordered by: James Morelock

R. 3, Box 744

Delavan, WI 53115

STATE OF WISCONSIN) SS
COUNTY OF WALWORTH)



I, George T. Dunham, Surveyor, certify that I have surveyed the property described as follows:

Lot 1 of Certified Survey No. 1900, recorded in Volume 9 of Certified Surveys on Page 90, Document No. 187632, in the Office of the Register of Deeds, Walworth County, Wisconsin, being a parcel of land located in the Northeast 1/4 of Section 2, T 2 N, R 15 E, Walworth County, Wisconsin,

and that the plat shown hereon is a correct representation thereof and shows the size and location of the property, its exterior boundaries, the location of all visible structures and dimensions of all principal buildings thereon, boundary fences, apparent easements, roadways and visible encroachments, if any, and that I have surveyed the property hereon described, according to the official records, to the best of my knowledge and belief.

February 5, 1990

George T. Dunham, Surveyor

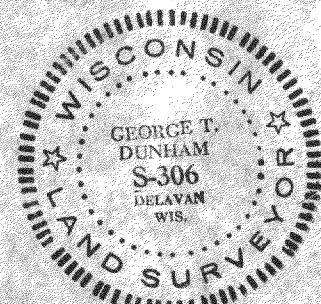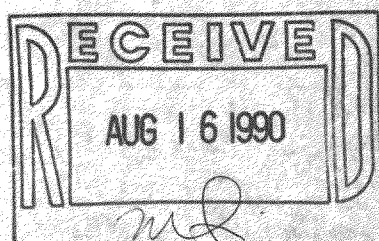

Survey # 215-280

TAX KEY # BA 19000001