


RIDGE PRAIRIE SCHOOL ROAD

ABELL SURVEYING & MAPPING

1140 SEQUOIA STREET • DELAVAN, WISCONSIN 53115
262-728-6737

NORTHWEST CORNER
SECTION 1-2-15

SOUTH 1177.47' (1177.40')
225.08' (1225.00')
NORTH
33.19' (33.04')
225.08'
33.04' (33.28')

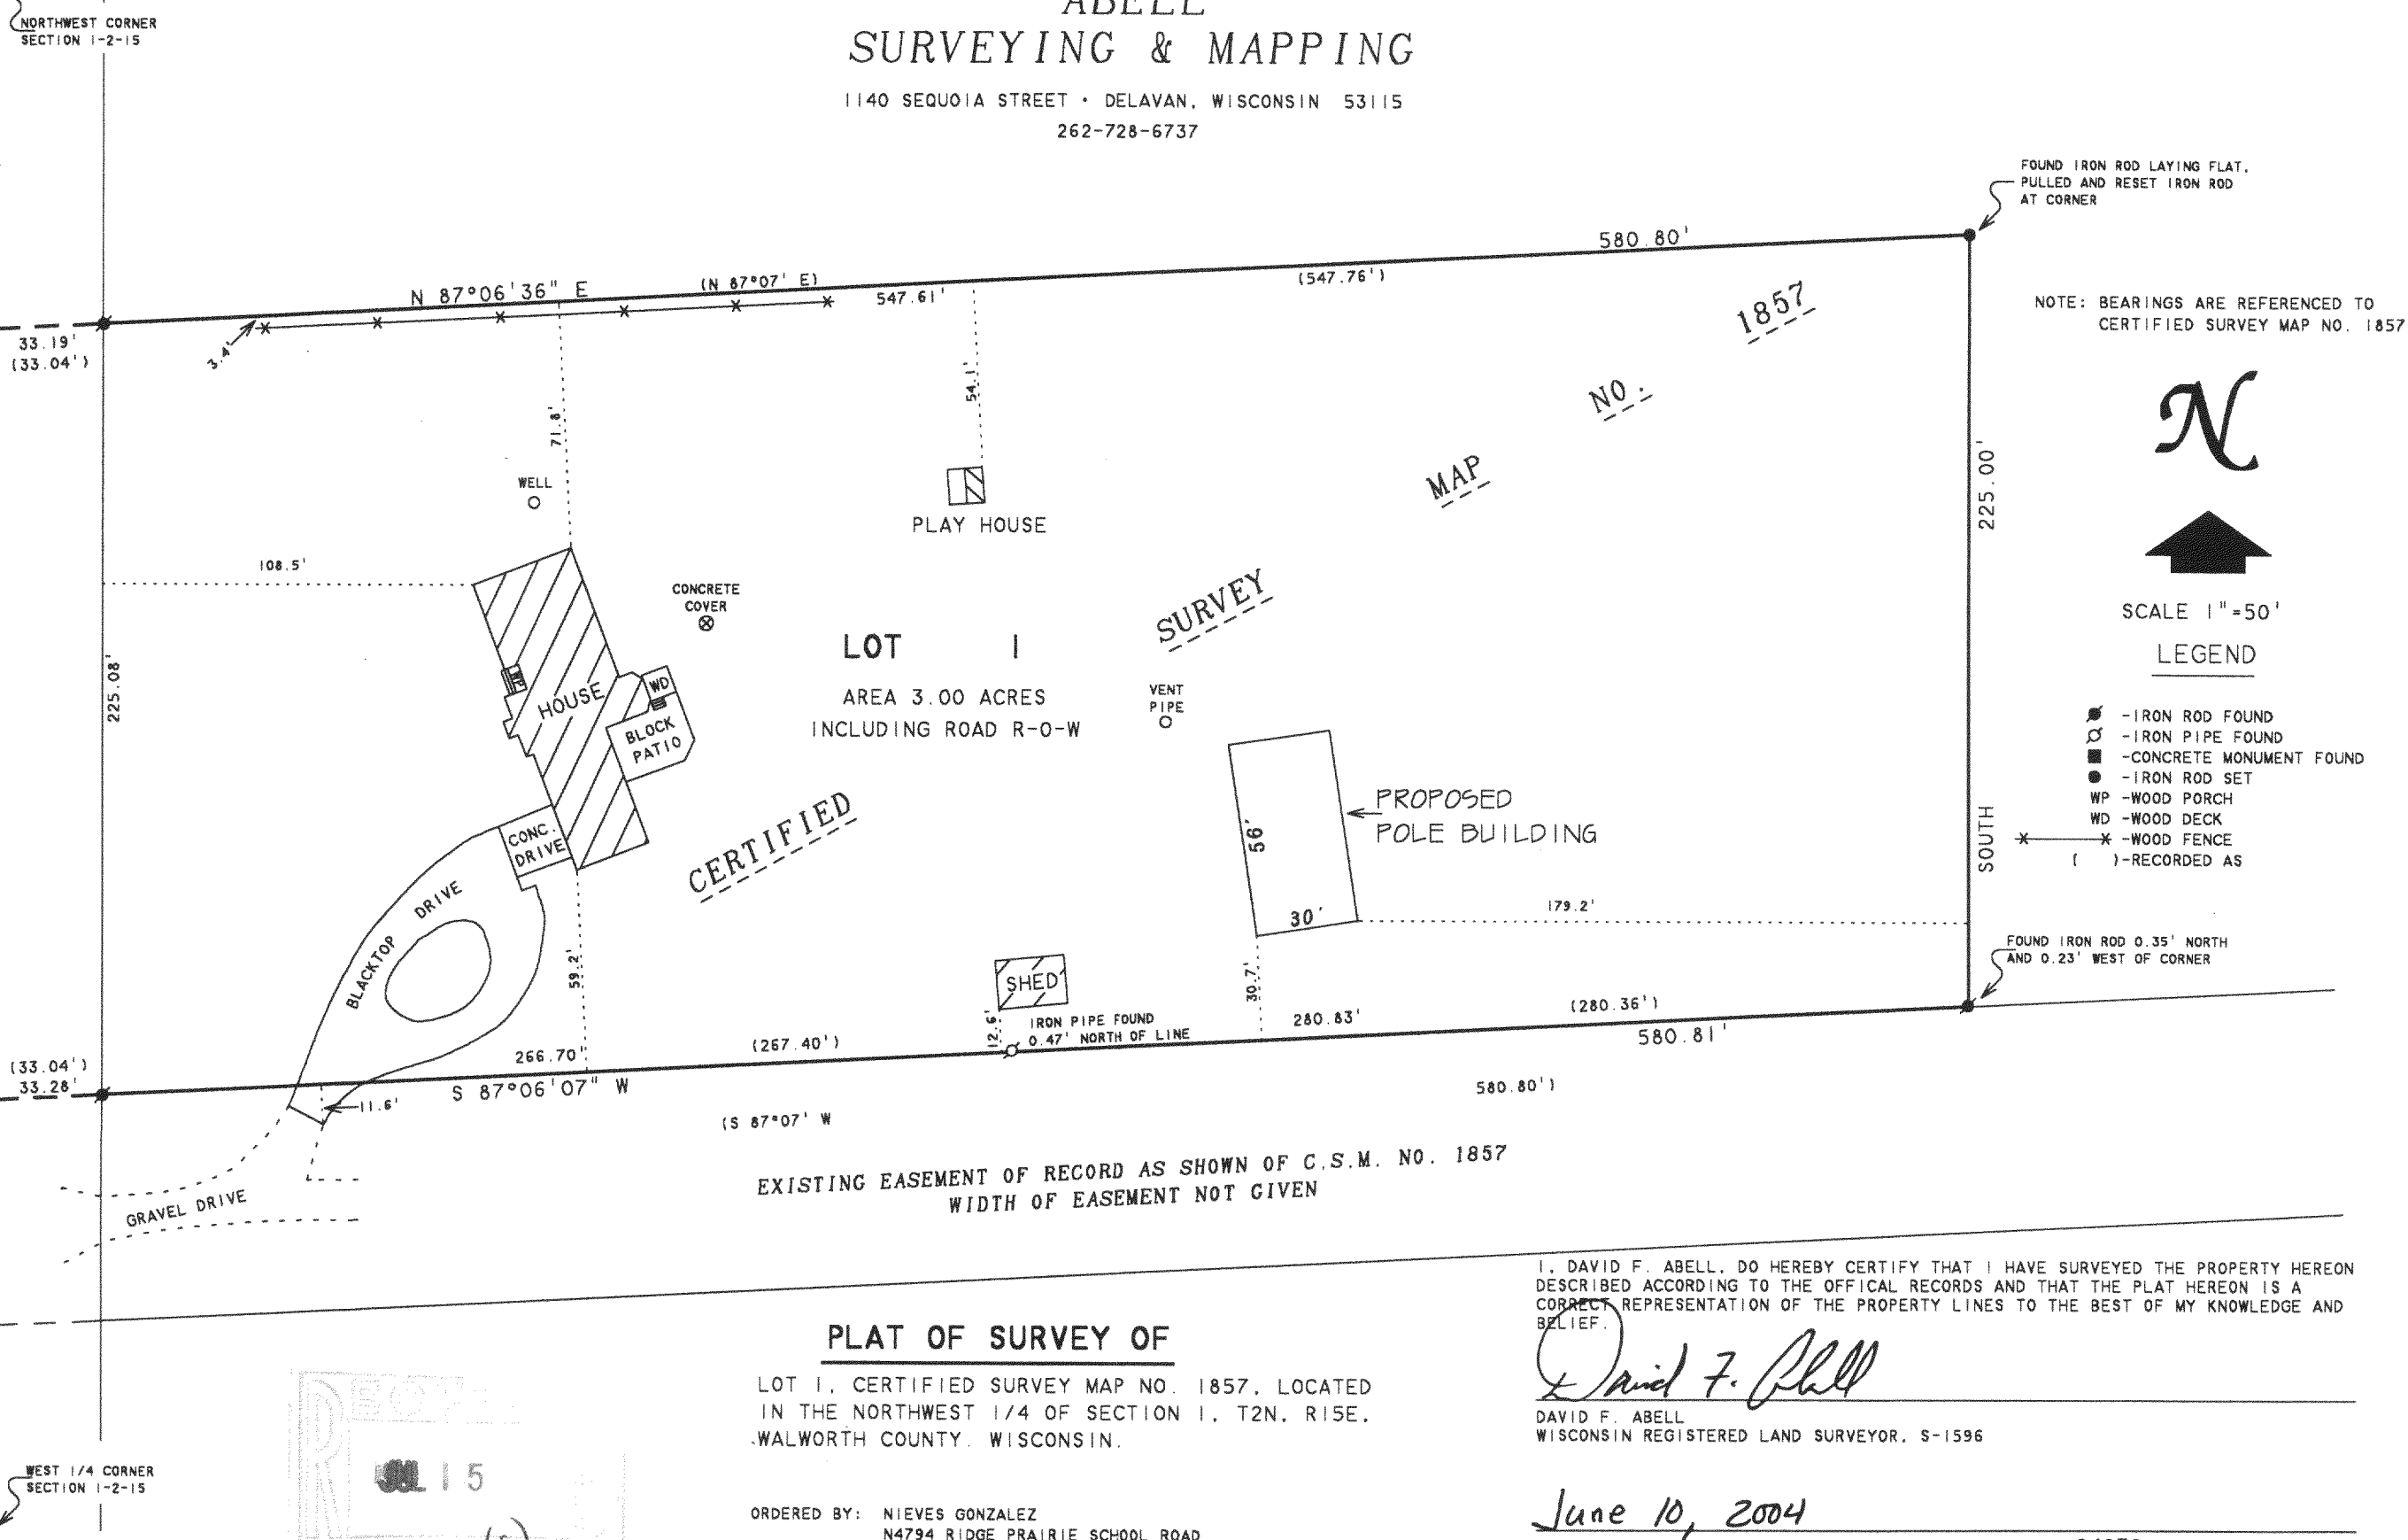

PLAT OF SURVEY OF

LOT 1, CERTIFIED SURVEY MAP NO. 1857, LOCATED
IN THE NORTHWEST 1/4 OF SECTION 1, T2N, R15E,
WALWORTH COUNTY, WISCONSIN.

ORDERED BY: NIEVES GONZALEZ
N4794 RIDGE PRAIRIE SCHOOL ROAD
DELAVAN, WI 53115


I, DAVID F. ABELL, DO HEREBY CERTIFY THAT I HAVE SURVEYED THE PROPERTY HEREON DESCRIBED ACCORDING TO THE OFFICAL RECORDS AND THAT THE PLAT HEREON IS A CORRECT REPRESENTATION OF THE PROPERTY LINES TO THE BEST OF MY KNOWLEDGE AND BELIEF.

David F. Abell

DAVID F. ABELL
WISCONSIN REGISTERED LAND SURVEYOR, S-1596

June 10, 2004

DATE: June 10, 2004 JOB NUMBER - 04070
NOTE: THIS IS NOT A CERTIFIED COPY UNLESS SEALED.

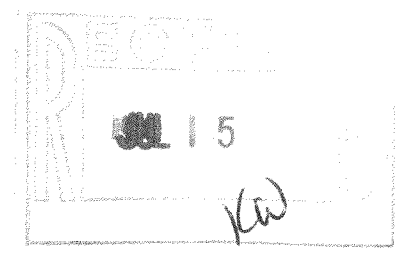

BA185700001

215-574