
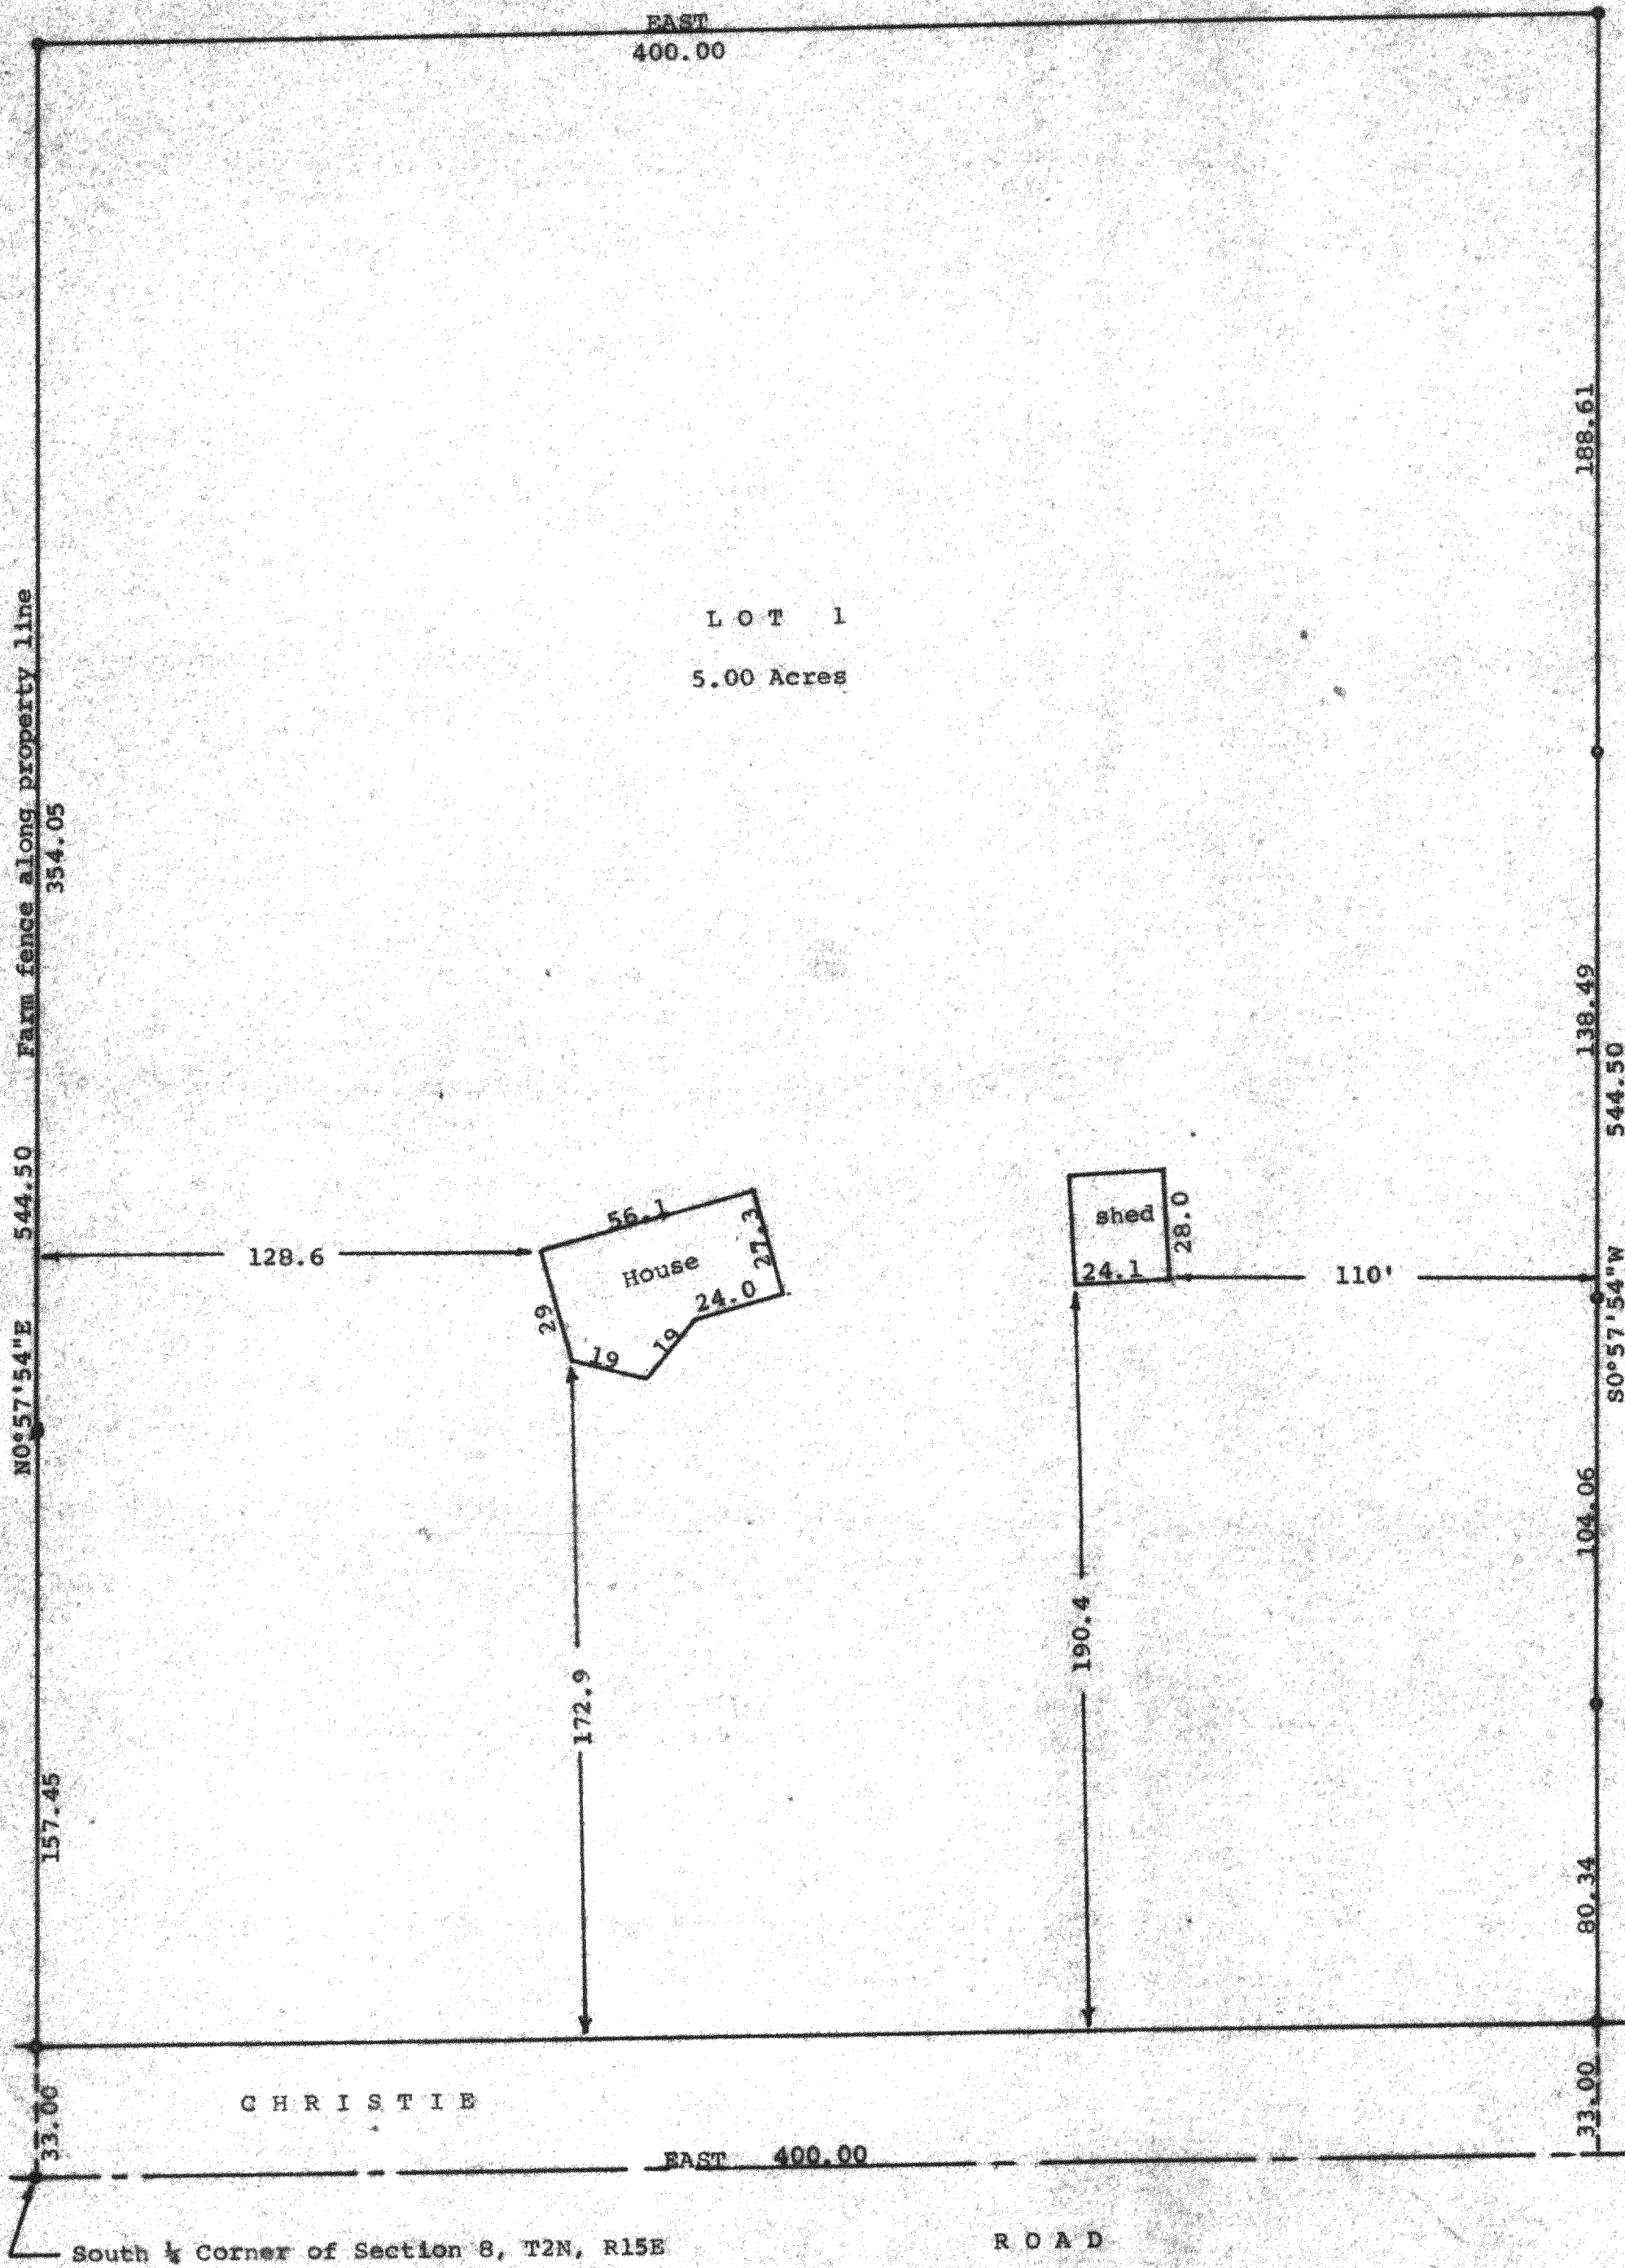


DUNHAM SURVEYING, S. C.
SURVEYING & SUBDIVIDING
DELAVAN, WISCONSIN 53115

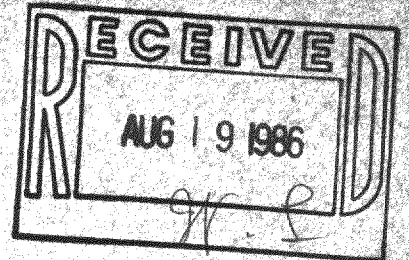

Scale - 1" = 40'
• = County Concrete Marker Found
o = 1" Iron Pipe
= 3/4" Iron Pipe
Bearings used are those shown on the
recorded Certified Survey Map
Survey ordered by:
First State Savings
23 South Washington
Elkhorn, WI 53121


STATE OF WISCONSIN) ss
COUNTY OF WALWORTH)

I, George T. Dunham, Surveyor, certify that I have surveyed the
property described as follows:

Lot 1 of Certified Survey No. 1367, recorded in Volume 6 of
Certified Surveys on Page 211, in the Office of the Register
of Deeds in Elkhorn, Wisconsin being a parcel of land located
in the Southeast 1/4 of Section 8, T 2 N, R 15 E, Walworth
County, Wisconsin,

and that the map shown above is a true representation thereof and shows
the size and location of the property, its exterior boundaries, the
location of all visible structures and dimensions of all principal buildings
thereon, boundary fences, apparent easements, roadways and visible encroachments,
if any, and that I have surveyed the property hereon described according to
the official records, to the best of my knowledge and belief.
August 24, 1984

George T. Dunham
George T. Dunham, Surveyor

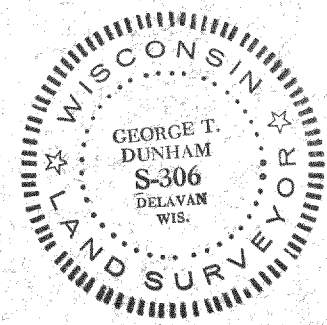

600
215-223