

Plat of Survey

of


Lot 2 of Certified Survey Map No. 3841,

located in the Southeast 1/4 of Section 36, Town 2 North,
Range 15 East, Town of Darien, Walworth County, Wisconsin.

Surveyed for:

Mary Brusa


N2626 Elm Ridge Road
Delavan, Wisconsin. 53115

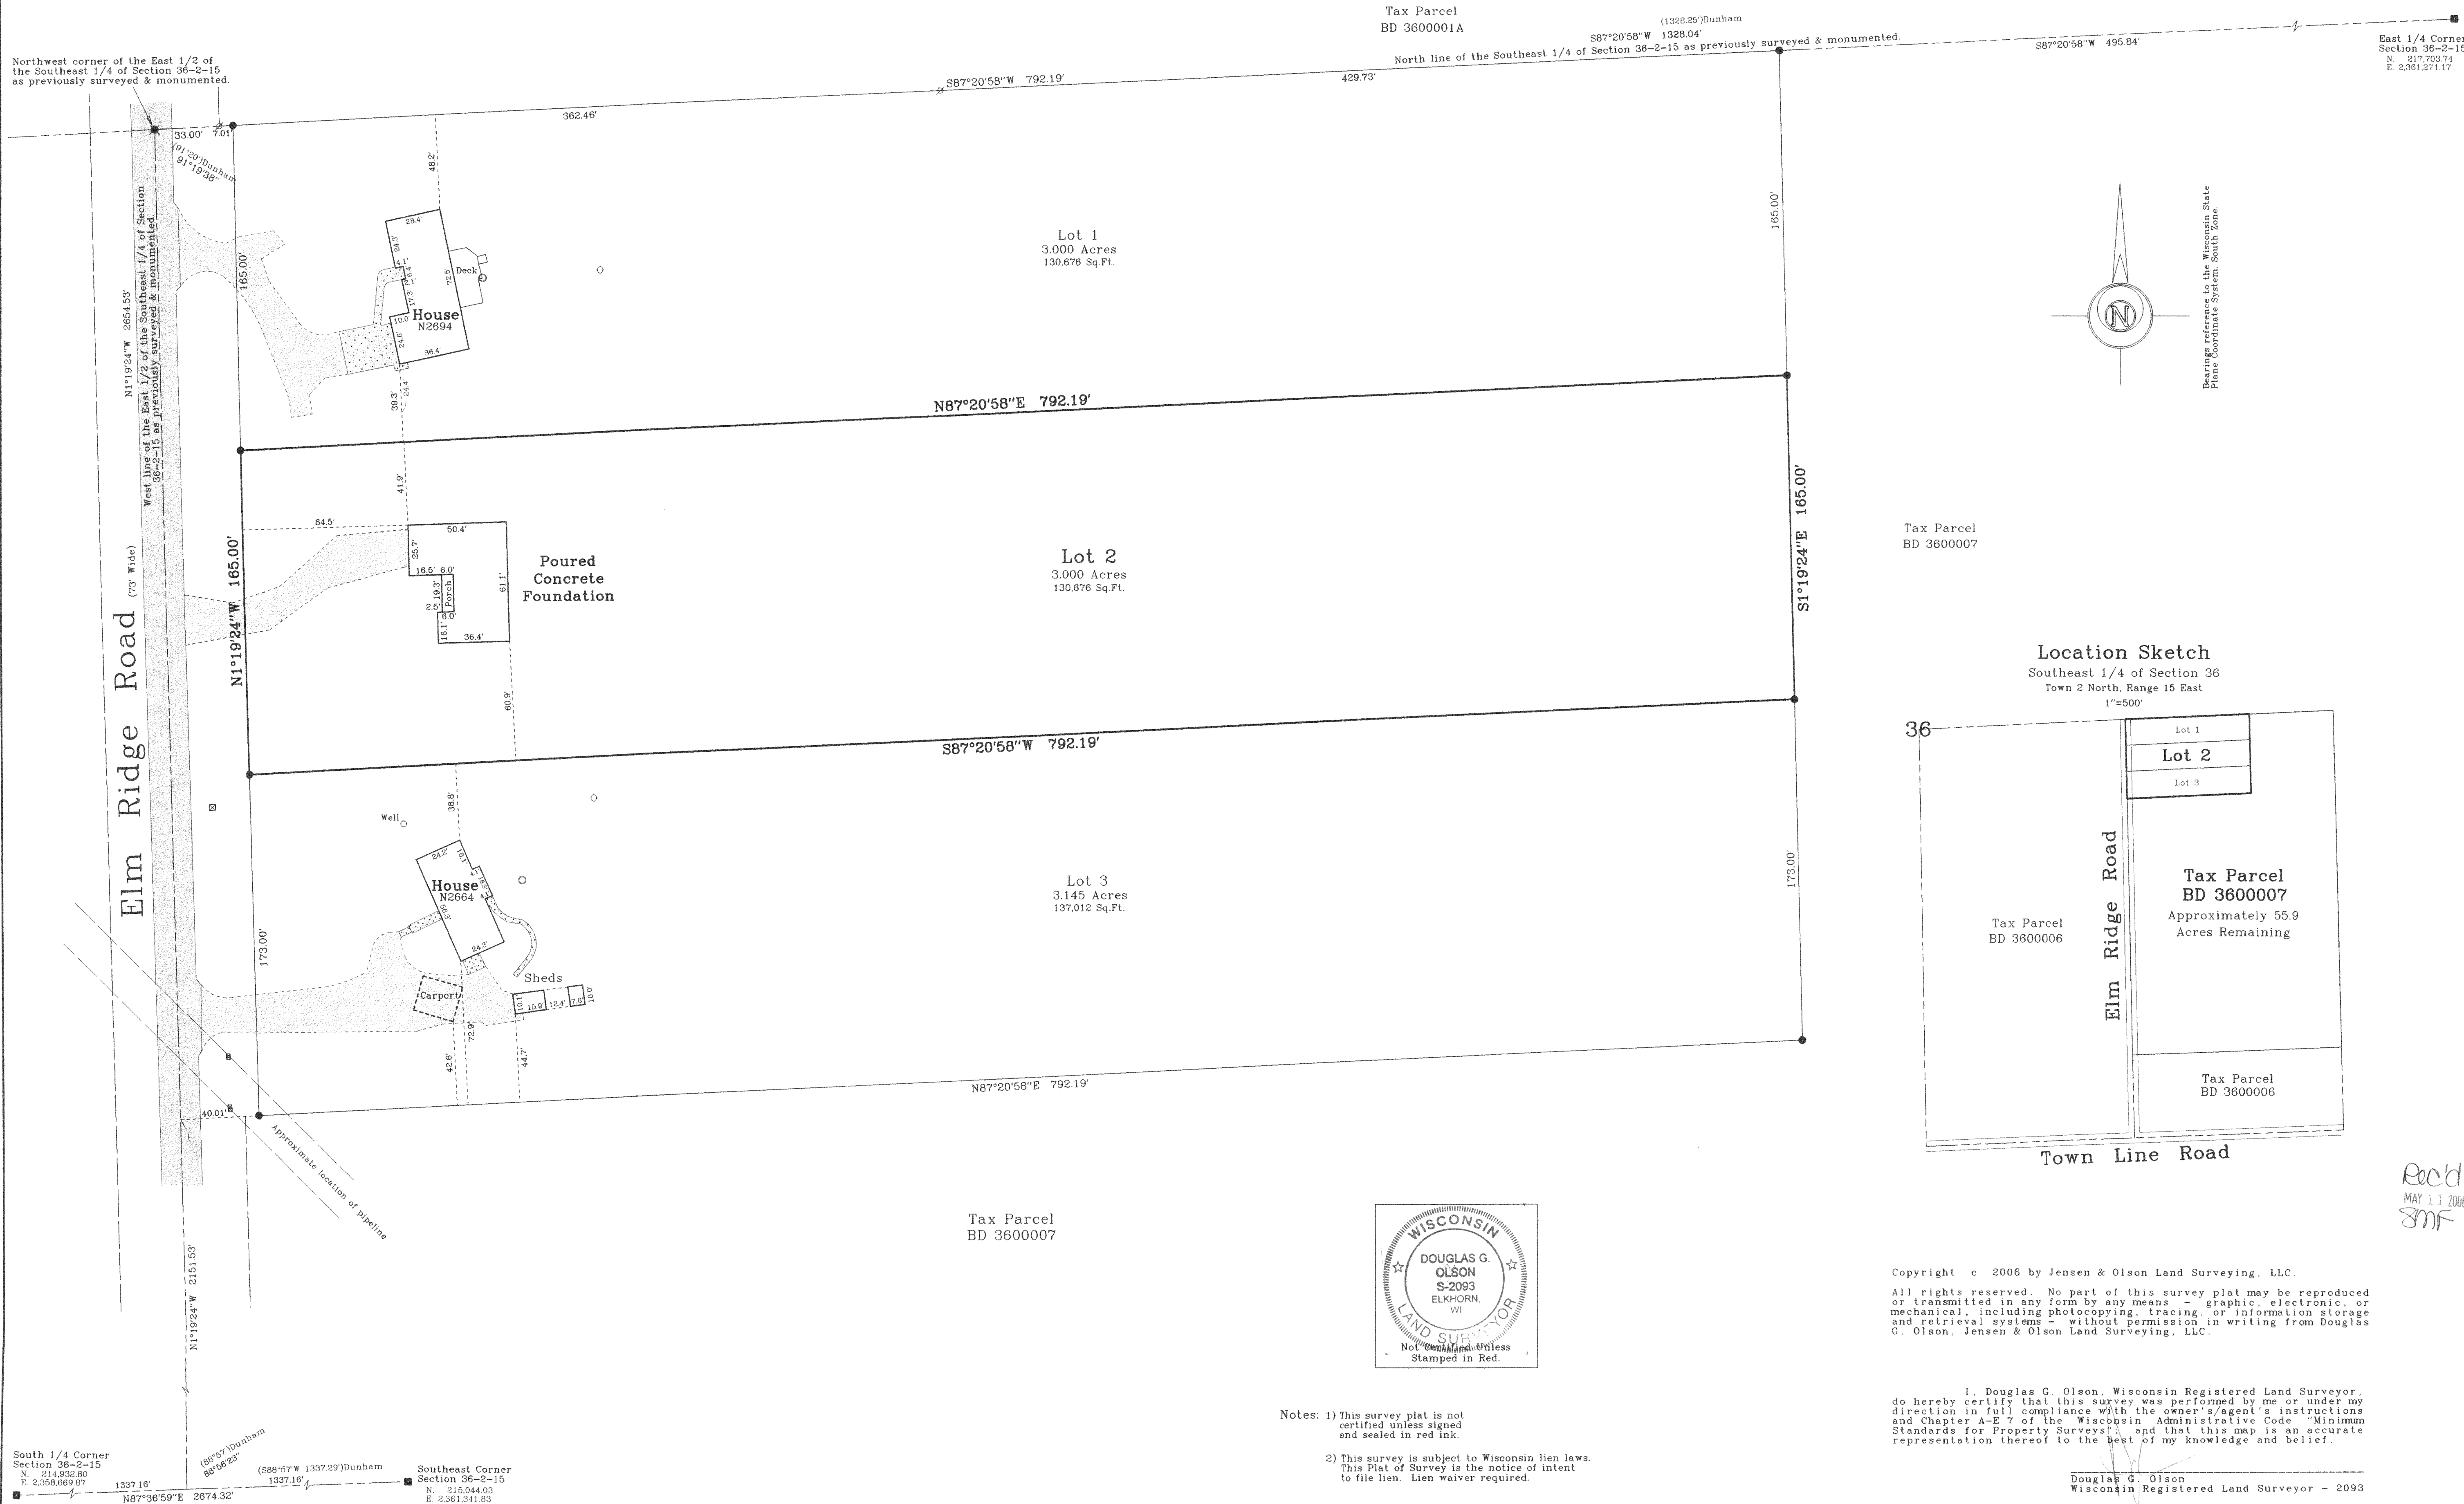

Location Sketch

Southeast 1/4 of Section 36
Town 2 North, Range 15 East

1"=500'

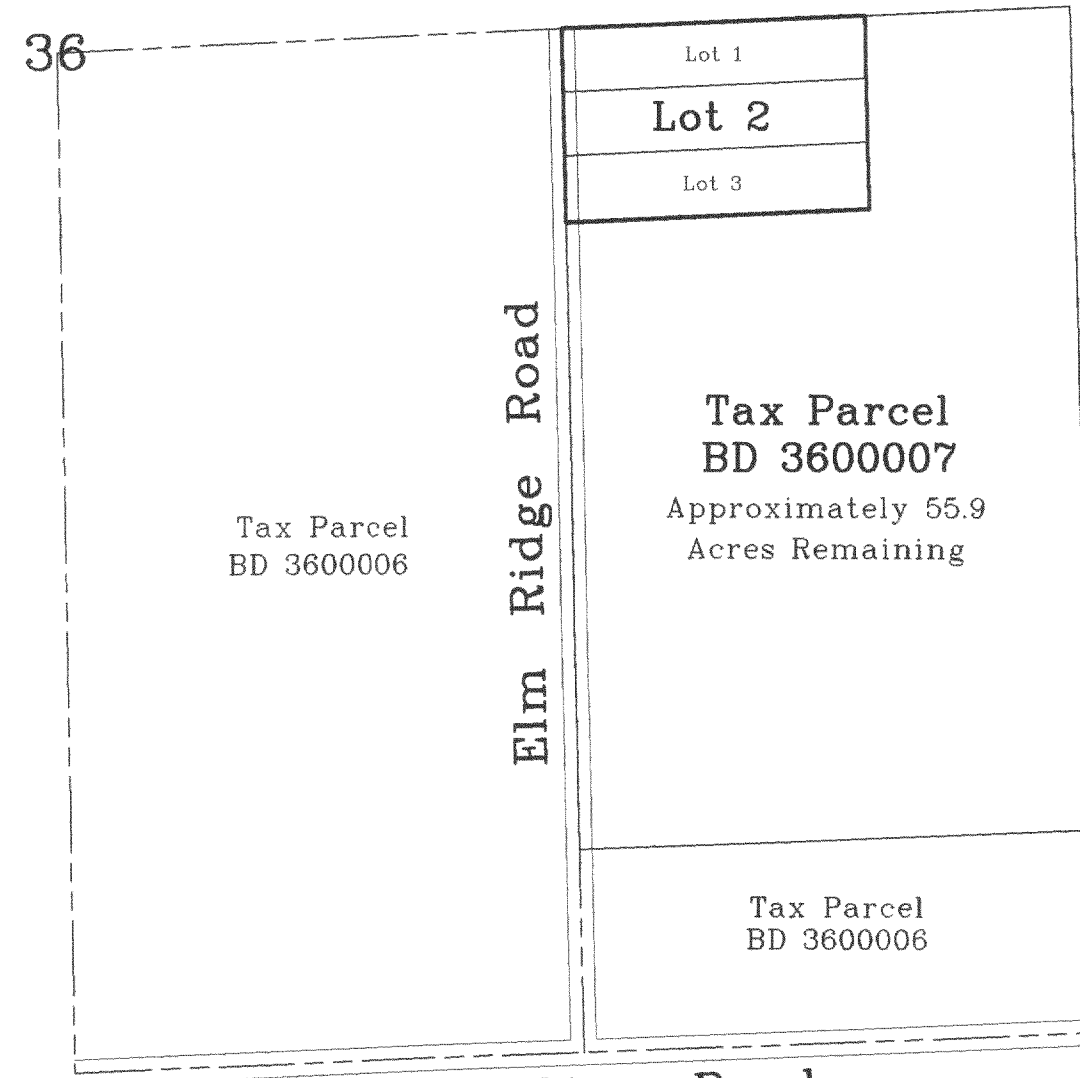

Scale in Feet

1" = 40'



Jensen & Olson Land Surveying, LLC

45 South Wisconsin Street P.O. Box 322
Elkhorn, Wisconsin 53121

Telephone: (262) 723-3434

Facsimile: (262) 723-8044

Legend

- Found County Section Corner
- Found Iron Rod, 3/4" dia.
- Found Railroad Spike
- Found Wood Stake
- Found Iron Rod, 1/2" dia.
- Found Wood Stake
- Found Iron Rod, 1/4" dia.
- Found Wood Stake
- Found Iron Rod, 1/8" dia.
- Found Wood Stake
- Found Iron Rod, 1/16" dia.
- Found Wood Stake
- Found Iron Rod, 1/32" dia.
- Found Wood Stake
- Found Iron Rod, 1/64" dia.
- Found Wood Stake
- Found Iron Rod, 1/128" dia.
- Found Wood Stake
- Found Iron Rod, 1/256" dia.
- Found Wood Stake
- Found Iron Rod, 1/512" dia.
- Found Wood Stake
- Found Iron Rod, 1/1024" dia.
- Found Wood Stake
- Found Iron Rod, 1/2048" dia.
- Found Wood Stake
- Found Iron Rod, 1/4096" dia.
- Found Wood Stake
- Found Iron Rod, 1/8192" dia.
- Found Wood Stake
- Found Iron Rod, 1/16384" dia.
- Found Wood Stake
- Found Iron Rod, 1/32768" dia.
- Found Wood Stake
- Found Iron Rod, 1/65536" dia.
- Found Wood Stake
- Found Iron Rod, 1/131072" dia.
- Found Wood Stake
- Found Iron Rod, 1/262144" dia.
- Found Wood Stake
- Found Iron Rod, 1/524288" dia.
- Found Wood Stake
- Found Iron Rod, 1/1048576" dia.
- Found Wood Stake
- Found Iron Rod, 1/2097152" dia.
- Found Wood Stake
- Found Iron Rod, 1/4194304" dia.
- Found Wood Stake
- Found Iron Rod, 1/8388608" dia.
- Found Wood Stake
- Found Iron Rod, 1/16777216" dia.
- Found Wood Stake
- Found Iron Rod, 1/33554432" dia.
- Found Wood Stake
- Found Iron Rod, 1/67108864" dia.
- Found Wood Stake
- Found Iron Rod, 1/134217728" dia.
- Found Wood Stake
- Found Iron Rod, 1/268435456" dia.
- Found Wood Stake
- Found Iron Rod, 1/536870912" dia.
- Found Wood Stake
- Found Iron Rod, 1/1073741824" dia.
- Found Wood Stake
- Found Iron Rod, 1/2147483648" dia.
- Found Wood Stake
- Found Iron Rod, 1/4294967296" dia.
- Found Wood Stake
- Found Iron Rod, 1/8589934592" dia.
- Found Wood Stake
- Found Iron Rod, 1/17179869184" dia.
- Found Wood Stake
- Found Iron Rod, 1/34359738368" dia.
- Found Wood Stake
- Found Iron Rod, 1/68719476736" dia.
- Found Wood Stake
- Found Iron Rod, 1/137438953472" dia.
- Found Wood Stake
- Found Iron Rod, 1/274877906944" dia.
- Found Wood Stake
- Found Iron Rod, 1/549755813888" dia.
- Found Wood Stake
- Found Iron Rod, 1/1099511627776" dia.
- Found Wood Stake
- Found Iron Rod, 1/2199023255552" dia.
- Found Wood Stake
- Found Iron Rod, 1/4398046511104" dia.
- Found Wood Stake
- Found Iron Rod, 1/8796093022208" dia.
- Found Wood Stake
- Found Iron Rod, 1/17592186044416" dia.
- Found Wood Stake
- Found Iron Rod, 1/35184372088832" dia.
- Found Wood Stake
- Found Iron Rod, 1/70368744177664" dia.
- Found Wood Stake
- Found Iron Rod, 1/140737488355328" dia.
- Found Wood Stake
- Found Iron Rod, 1/281474976710656" dia.
- Found Wood Stake
- Found Iron Rod, 1/562949953421312" dia.
- Found Wood Stake
- Found Iron Rod, 1/1125899906842624" dia.
- Found Wood Stake
- Found Iron Rod, 1/2251799813685248" dia.
- Found Wood Stake
- Found Iron Rod, 1/4503599627370496" dia.
- Found Wood Stake
- Found Iron Rod, 1/9007199254740992" dia.
- Found Wood Stake
- Found Iron Rod, 1/18014398509481984" dia.
- Found Wood Stake
- Found Iron Rod, 1/36028797018963968" dia.
- Found Wood Stake
- Found Iron Rod, 1/72057594037927936" dia.
- Found Wood Stake
- Found Iron Rod, 1/144115188075855872" dia.
- Found Wood Stake
- Found Iron Rod, 1/288230376151711744" dia.
- Found Wood Stake
- Found Iron Rod, 1/576460752303423488" dia.
- Found Wood Stake
- Found Iron Rod, 1/1152921504606846976" dia.
- Found Wood Stake
- Found Iron Rod, 1/2305843009213693952" dia.
- Found Wood Stake
- Found Iron Rod, 1/4611686018427387904" dia.
- Found Wood Stake
- Found Iron Rod, 1/9223372036854775808" dia.
- Found Wood Stake
- Found Iron Rod, 1/18446744073709551616" dia.
- Found Wood Stake
- Found Iron Rod, 1/36893488147419103232" dia.
- Found Wood Stake
- Found Iron Rod, 1/73786976294838206464" dia.
- Found Wood Stake
- Found Iron Rod, 1/147573952589676412928" dia.
- Found Wood Stake
- Found Iron Rod, 1/295147905179352825856" dia.
- Found Wood Stake
- Found Iron Rod, 1/590295810358705651712" dia.
- Found Wood Stake
- Found Iron Rod, 1/1180591620717411303424" dia.
- Found Wood Stake
- Found Iron Rod, 1/2361183241434822606848" dia.
- Found Wood Stake
- Found Iron Rod, 1/4722366482869645213696" dia.
- Found Wood Stake
- Found Iron Rod, 1/9444732965739290427392" dia.
- Found Wood Stake
- Found Iron Rod, 1/18889465931478580854784" dia.
- Found Wood Stake
- Found Iron Rod, 1/37778931862957161709568" dia.
- Found Wood Stake
- Found Iron Rod, 1/75557863725914323419136" dia.
- Found Wood Stake
- Found Iron Rod, 1/151115727451828646838272" dia.
- Found Wood Stake
- Found Iron Rod, 1/302231454903657293676544" dia.
- Found Wood Stake
- Found Iron Rod, 1/604462909807314587353088" dia.
- Found Wood Stake
- Found Iron Rod, 1/1208925819614629174706176" dia.
- Found Wood Stake
- Found Iron Rod, 1/2417851639229258349412352" dia.
- Found Wood Stake
- Found Iron Rod, 1/4835703278458516698824704" dia.
- Found Wood Stake
- Found Iron Rod, 1/9671406556917033397649408" dia.
- Found Wood Stake
- Found Iron Rod, 1/19342813113834066793298816" dia.
- Found Wood Stake
- Found Iron Rod, 1/38685626227668133586597632" dia.
- Found Wood Stake
- Found Iron Rod, 1/77371252455336267173195264" dia.
- Found Wood Stake
- Found Iron Rod, 1/154742504910672534346390528" dia.
- Found Wood Stake
- Found Iron Rod, 1/309485009821345068692781056" dia.
- Found Wood Stake
- Found Iron Rod, 1/618970019642690137385562112" dia.
- Found Wood Stake
- Found Iron Rod, 1/1237940039285380274771124224" dia.
- Found Wood Stake
- Found Iron Rod, 1/2475880078570760549542248448" dia.
- Found Wood Stake
- Found Iron Rod, 1/4951760157141521099084496896" dia.
- Found Wood Stake
- Found Iron Rod, 1/9903520314283042198168993792" dia.
- Found Wood Stake
- Found Iron Rod, 1/19807040628566084396337987584" dia.
- Found Wood Stake
- Found Iron Rod, 1/39614081257132168792675975168" dia.
- Found Wood Stake
- Found Iron Rod, 1/79228162514264337585351950336" dia.
- Found Wood Stake
- Found Iron Rod, 1/158456325028528675170703900672" dia.
- Found Wood Stake
- Found Iron Rod, 1/316912650057057350341407801344" dia.
- Found Wood Stake
- Found Iron Rod, 1/633825300114114700682815602688" dia.
- Found Wood Stake
- Found Iron Rod, 1/1267650600228229401365631205376" dia.
- Found Wood Stake
- Found Iron Rod, 1/2535301200456458802731262410752" dia.
- Found Wood Stake
- Found Iron Rod, 1/5070602400912917605462524821504" dia.
- Found Wood Stake
- Found Iron Rod, 1/10141204801825835210925049643008" dia.
- Found Wood Stake
- Found Iron Rod, 1/20282409603651670421850099286016" dia.
- Found Wood Stake
- Found Iron Rod, 1/40564819207303340843700198572032" dia.
- Found Wood Stake
- Found Iron Rod, 1/81129638414606681687400397144064" dia.
- Found Wood Stake
- Found Iron Rod, 1/162259276829213363754800784288128" dia.
- Found Wood Stake
- Found Iron Rod, 1/324518553658426727509601568576256" dia.
- Found Wood Stake
- Found Iron Rod, 1/649037107316853455019203137152512" dia.
- Found Wood Stake
- Found Iron Rod, 1/1298074214633706910038406274305024" dia.
- Found Wood Stake
- Found Iron Rod, 1/2596148429267413820076812548610048" dia.
- Found Wood Stake
- Found Iron Rod, 1/5192296858534827640153625097220096" dia.
- Found Wood Stake
- Found Iron Rod, 1/10384593717069655280307251194400192" dia.
- Found Wood Stake
- Found Iron Rod, 1/20769187434139310560614502388800384" dia.
- Found Wood Stake
- Found Iron Rod, 1/41538374868278621121229004777600768" dia.
- Found Wood Stake
- Found Iron Rod, 1/83076749736557242242458009555201536" dia.
- Found Wood Stake
- Found Iron Rod, 1/166153499473114484484916019110403072" dia.
- Found Wood Stake
- Found Iron Rod, 1/332306998946228968969832038220806144" dia.
- Found Wood Stake
- Found Iron Rod, 1/664613997892457937939664076441612288" dia.
- Found Wood Stake
- Found Iron Rod, 1/1329227995784915875879328152883245568" dia.
- Found Wood Stake
- Found Iron Rod, 1/2658455991569831751758656305766491136" dia.
- Found Wood Stake
- Found Iron Rod, 1/5316911983139663503517312611532982272" dia.
- Found Wood Stake
- Found Iron Rod, 1/10633823966279327007034625223065964544" dia.
- Found Wood Stake
- Found Iron Rod, 1/21267647932558654014069250446131929088" dia.
- Found Wood Stake
- Found Iron Rod, 1/42535295865117308028138500892263858176" dia.
- Found Wood Stake
- Found Iron Rod, 1/85070591730234616056277001784527716352" dia.
- Found Wood Stake
- Found Iron Rod, 1/170141183460469232112554003569055432704" dia.
- Found Wood Stake
- Found Iron Rod, 1/340282366920938464225108007138110865408" dia.
- Found Wood Stake
- Found Iron Rod, 1/680564733841876928450216014276221730816" dia.
- Found Wood Stake
- Found Iron Rod, 1/1361129467683753856900432028552443461632" dia.
- Found Wood Stake
- Found Iron Rod, 1/2722258935367507713800864057104886923264" dia.
- Found Wood Stake
- Found Iron Rod, 1/5444517870735015427601728114209773846528" dia.
- Found Wood Stake
- Found Iron Rod, 1/10889035741470030855203456228419547693056" dia.
- Found Wood Stake
- Found Iron Rod, 1/21778071482940061710406912456839095386112" dia.
- Found Wood Stake
- Found Iron Rod, 1/43556142965880123420813824913678190772224" dia.
- Found Wood Stake
- Found Iron Rod, 1/87112285931760246841627649827356381544448" dia.
- Found Wood Stake
- Found Iron Rod, 1/17422457186352049368325529965471276288896" dia.
- Found Wood Stake
- Found Iron Rod, 1/34844914372704098736651059930942552577792" dia.
- Found Wood Stake
- Found Iron Rod, 1/69689828745408197473302119861885105155584" dia.
- Found Wood Stake
- Found Iron Rod, 1/139379657490816394946604239723770210311168" dia.
- Found Wood Stake
- Found Iron Rod, 1/278759314981632789893208479447540420622336" dia.
- Found Wood Stake
- Found Iron Rod, 1/557518629963265579786416958895080841244672" dia.
- Found Wood Stake
- Found Iron Rod, 1/1115037259926531159572833917790161682489344" dia.
- Found Wood Stake
- Found Iron Rod, 1/2230074519853062319145667835580323364978688" dia.
- Found Wood Stake
- Found Iron Rod, 1/4460149039706124638291335671160646729957376" dia.
- Found Wood Stake
- Found Iron Rod, 1/8920298079412249276582671342321293459914752" dia.
- Found Wood Stake
- Found Iron Rod, 1/17840596158824498553165342844625869199829504" dia.
- Found Wood Stake
- Found Iron Rod, 1/35681192317648997106330685689251738399659008" dia.
- Found Wood Stake
- Found Iron Rod, 1/71362384635297994212661371378503476799318016" dia.
- Found Wood Stake
- Found Iron Rod, 1/142724769270595988425322742757006953598636032" dia.
- Found Wood Stake
- Found Iron Rod, 1/285449538541191976850645485514013907197272064" dia.
- Found Wood Stake
- Found Iron Rod, 1/570899077082383953701290971028027814394544128" dia.
- Found Wood Stake
- Found Iron Rod, 1/1141798154164767907402581942056055628789088256" dia.
- Found Wood Stake
- Found Iron Rod, 1/2283596308329535814805163884112111257578176512" dia.
- Found Wood Stake
- Found Iron Rod, 1/4567192616659071629610327768224222515156353024" dia.
- Found Wood Stake
- Found Iron Rod, 1/9134385233318143259220655536448445030312706048" dia.
- Found Wood Stake
- Found Iron Rod, 1/18268770466636286518441311072896900660625412096" dia.
- Found Wood Stake
- Found Iron Rod, 1/36537540933272573036882622145793801321250824192" dia.
- Found Wood Stake
- Found Iron Rod, 1/73075081866545146073765244291587602642501648384" dia.
- Found Wood Stake
- Found Iron Rod, 1/146150163733090292147530488583175205285003296768" dia.
- Found Wood Stake
- Found Iron Rod, 1/292300327466180584295060977166350410570006593536" dia.
- Found Wood Stake
- Found Iron Rod, 1/584600654932361168590121954332700821140013187072" dia.
- Found Wood Stake
- Found Iron Rod, 1/1169201309864722337180243908665401642280026374144" dia.
- Found Wood Stake
- Found Iron Rod, 1/2338402619729444674360487817330803284560052748288" dia.
- Found Wood Stake
- Found Iron Rod, 1/4676805239458889348720975634661606569120105496576" dia.
- Found Wood Stake
- Found Iron Rod, 1/9353610478917778697441951269323213138240210993152" dia.
- Found Wood Stake
- Found Iron Rod, 1/18707220957835557394883902538646426276480421986304" dia.
- Found Wood Stake
- Found Iron Rod, 1/37414441915671114789767805077292852552960843972608" dia.
- Found Wood Stake
- Found Iron Rod, 1/74828883831342229579535610154585705105921687945216" dia.
- Found Wood Stake
- Found Iron Rod, 1/149657767662684459159071220309711411843243375890432" dia.
- Found Wood Stake
- Found Iron Rod, 1/299315535325368918318142440619422823686486751780864" dia.
- Found Wood Stake
- Found Iron Rod, 1/598631070650737836636284881238845647372973503561728" dia.
- Found Wood Stake
- Found Iron Rod, 1/1197262141301475673272569762477691294745947007123456" dia.
- Found Wood Stake
- Found Iron Rod, 1/2394524282602951346545139524955822589491894014247104" dia.
- Found Wood Stake
- Found Iron Rod, 1/4789048565205902693090279049911645179083788028494208" dia.
- Found Wood Stake
- Found Iron Rod, 1/9578097130411805386180558099823290378167576056988416" dia.
- Found Wood Stake
- Found Iron Rod, 1/19156194260823610772361111799646580756335152113976832" dia.
- Found Wood Stake
- Found Iron Rod, 1/38312388521647221544722223599293161512670304227953664" dia.
- Found Wood Stake
- Found Iron Rod, 1/76624777043294443089444447198586323025340608455907328" dia.
- Found Wood Stake
- Found Iron Rod, 1/153249554086588886178888894397172646050681216911814656" dia.
- Found Wood Stake
- Found Iron Rod, 1/306499108173177772357777788794345292101362433823629312" dia.
- Found Wood Stake
- Found Iron Rod, 1/612998216346355544715555577588690584202724867647258624" dia.
- Found Wood Stake
- Found Iron Rod, 1/1225996432692711089431111155177381168405449735294517248" dia.
- Found Wood Stake
- Found Iron Rod, 1/2451992865385422178862222310354762336810899470589034496" dia.
- Found Wood Stake
- Found Iron Rod, 1/4903985730770844357724444620709524673621798941178068992" dia.
- Found Wood Stake
- Found Iron Rod, 1/9807971461541688715448889241419049347243597882356137984" dia.
- Found Wood Stake
- Found Iron Rod, 1/19615942922883377430897778482838098694487195764712275888" dia.
- Found Wood Stake
- Found Iron Rod, 1/39231885845766754861795556965676197388974391529424551776" dia.
- Found Wood Stake
- Found Iron Rod, 1/78463771691533509723591113931352394777948783058849103552" dia.
- Found Wood Stake
- Found Iron Rod, 1/156927543383067019447182227862707995555897566117698207104" dia.
- Found Wood Stake
- Found Iron Rod, 1/313855086766134038894364457725415991111795132235396414208" dia.
- Found Wood Stake
- Found Iron Rod, 1/627710173532268077788728915450831982223590264470792828416" dia.
- Found Wood Stake
- Found Iron Rod, 1/1255420347064536155577577830901663964447180528941585656832" dia.
- Found Wood Stake
- Found Iron Rod, 1/2510840694129072311155155560180327928894361057883171313664" dia.
- Found Wood Stake
- Found Iron Rod, 1/5021681388258144622310311203760655857788722115766342627328" dia.
- Found Wood Stake
- Found Iron Rod, 1/10043362776516289244620622407521311715577444231532685254656" dia.
- Found Wood Stake
- Found Iron Rod, 1/20086725553032578489241244815042623431154888463065370509312" dia.
- Found Wood Stake
- Found Iron Rod, 1/40173451106065156978482489630085246823089777326131371018624" dia.
- Found Wood Stake
- Found Iron Rod, 1/80346902212130313956964979260170493746179554652262674037248" dia.
- Found Wood Stake
- Found Iron Rod, 1/16069380442426067811392995852034098749235910930452534807456" dia.
- Found Wood Stake
- Found Iron Rod, 1/3213876088485213562278599170406819749847182186090