



ABELL
SURVEYING & MAPPING
1140 SEQUOIA STREET • DELAVAN, WISCONSIN 53115
262-728-6737

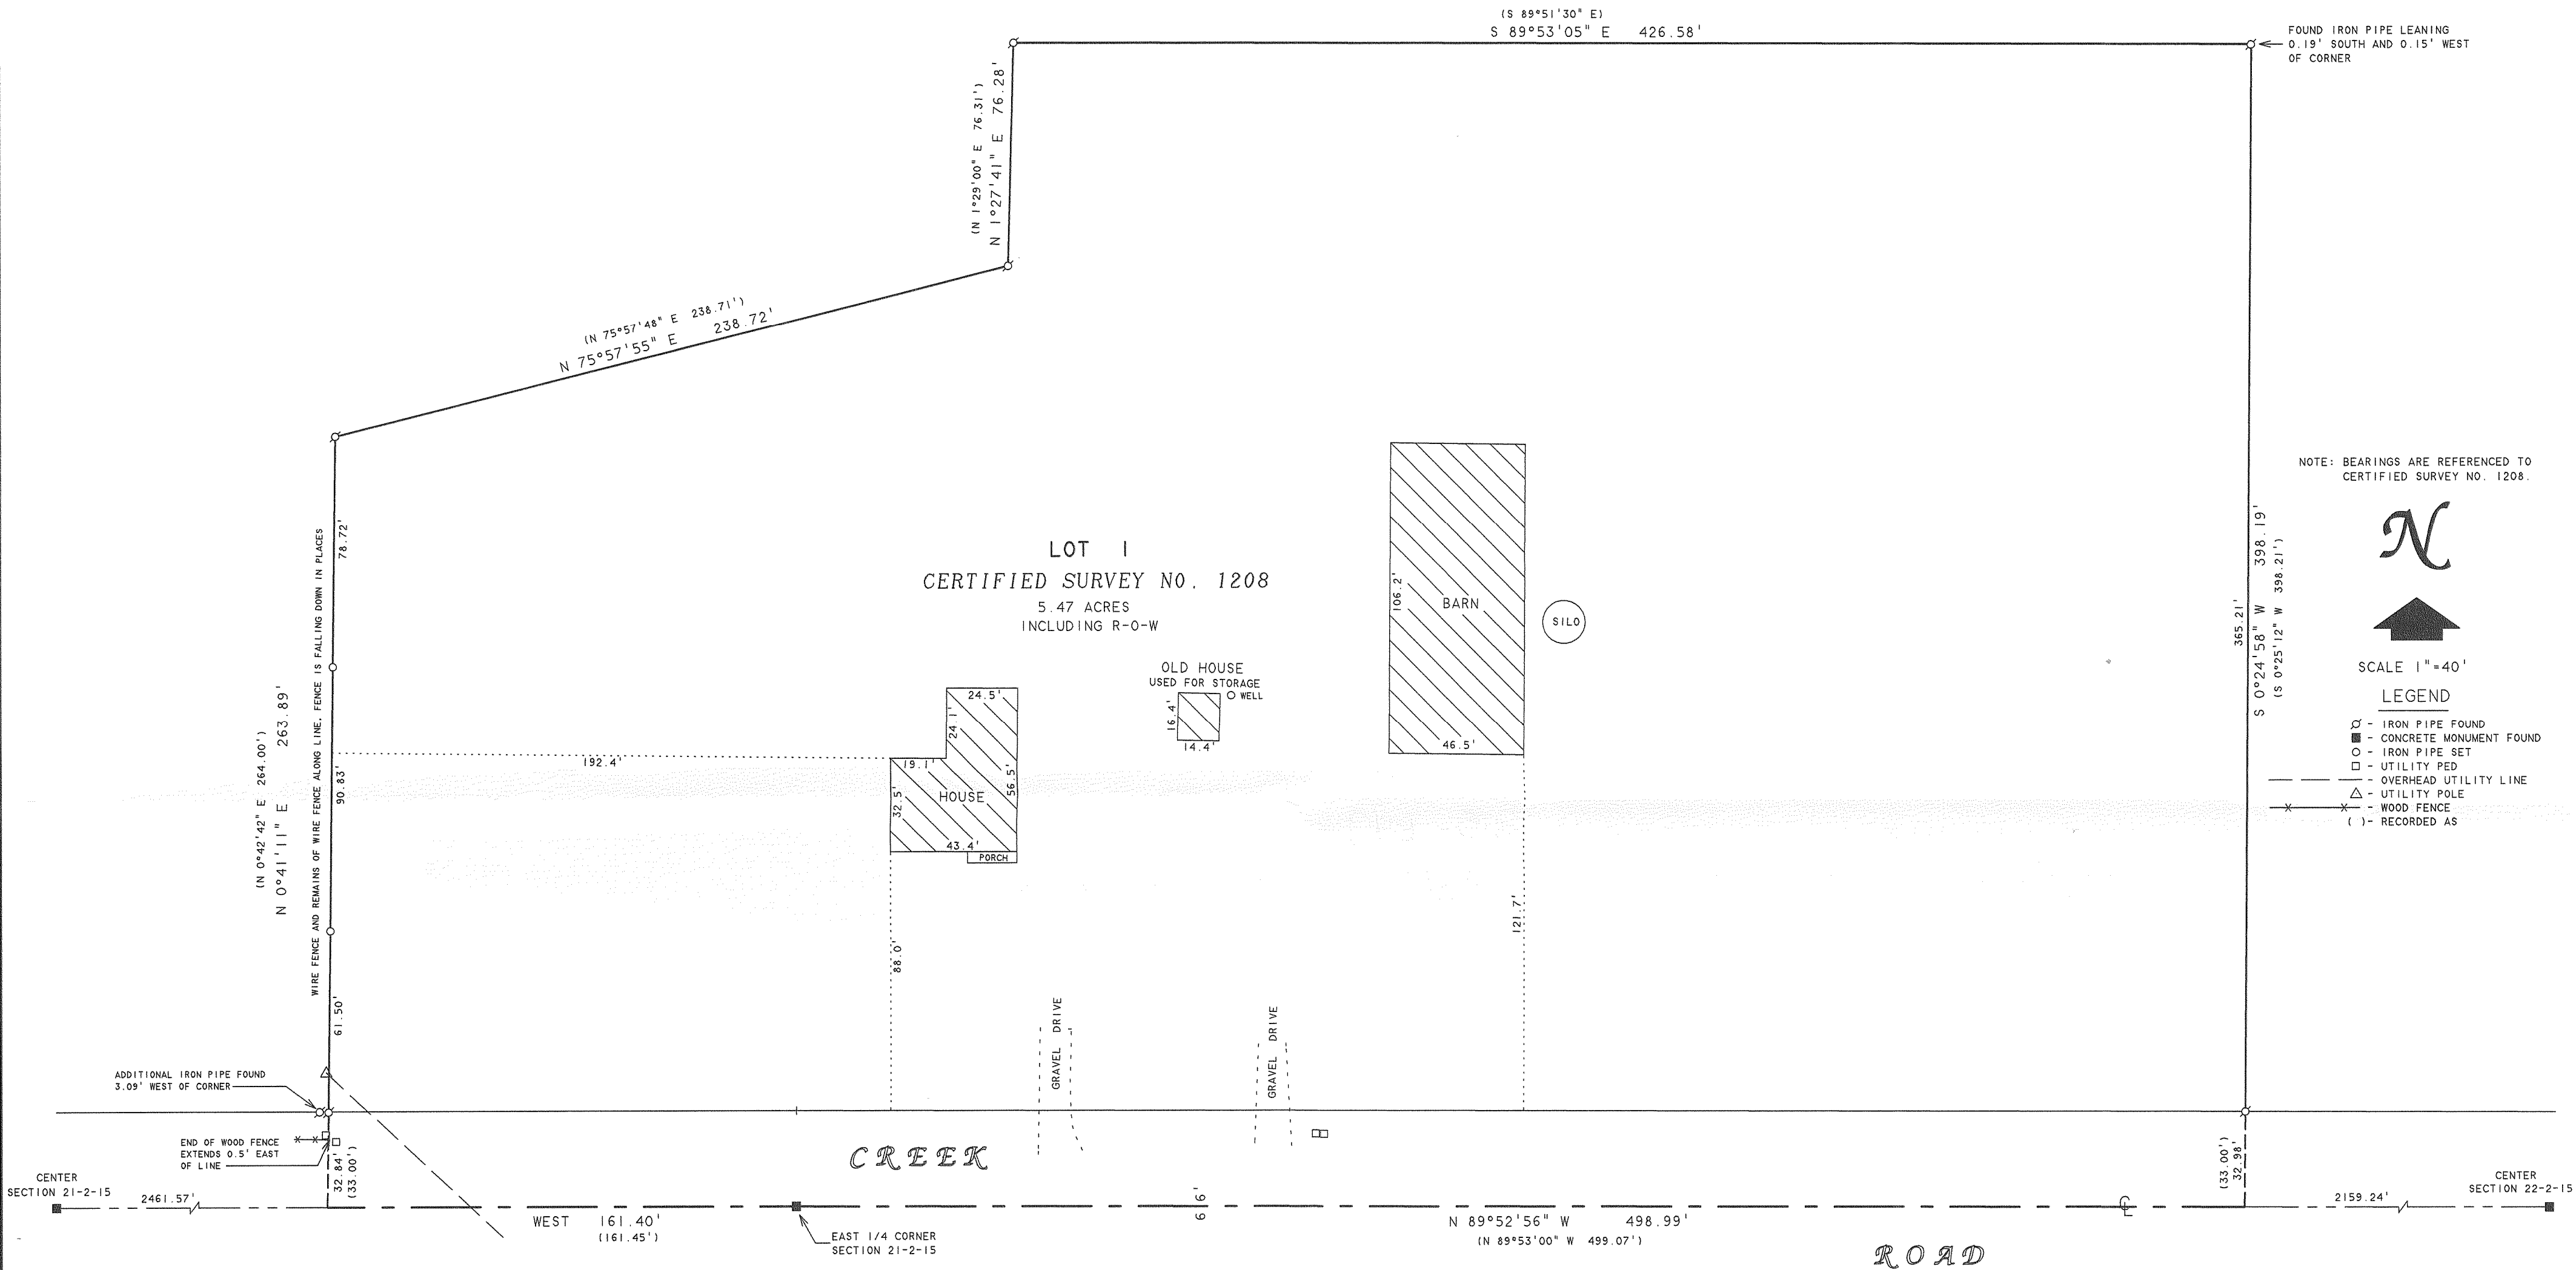

PLAT OF SURVEY OF

LOT 1, CERTIFIED SURVEY NO. 1208, LOCATED IN THE NORTHEAST 1/4 OF SECTION 21 AND THE NORTHWEST 1/4 OF SECTION 22, T2N.R15E, WALWORTH COUNTY, WISCONSIN.

ORDERED BY: CHARLES LOVACK
W8494 CREEK ROAD
DELAVAN, WI 53115

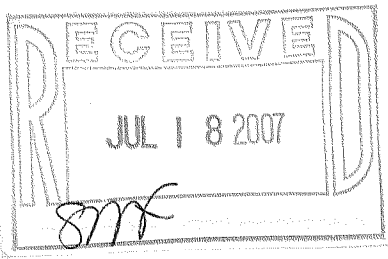

I, DAVID F. ABELL, DO HEREBY CERTIFY THAT I HAVE SURVEYED THE PROPERTY HEREON DESCRIBED ACCORDING TO THE OFFICIAL RECORDS AND THAT THE PLAT HEREON IS A CORRECT REPRESENTATION OF THE PROPERTY LINES TO THE BEST OF MY KNOWLEDGE AND BELIEF.

David F. Abell

DAVID F. ABELL
WISCONSIN REGISTERED LAND SURVEYOR, S-1596

January 3, 2007

DATE: January 3, 2007 JOB NUMBER - 06118
NOTE: THIS IS NOT A CERTIFIED COPY UNLESS SEALED.

BA1208-1

215-649