

Tax Parcel
BD 500001

Tax Parcel
BD 500001

Lot 1
Tax Parcel
BA436700001

5.000 Acres
217,800 Sq.Ft.

N0°30'45"E 543.13'

S89°07'49"E 407.85'

117.0'

117.1'

Barn

Barn

Shed

Garage

House
N4781

Porch

Well

Overhead Wires

Sign

Guy

Overhead Wires

Overhead Wires

Southeast Corner
Section 32-3-15.
N. 245,903.82
E. 2,339,683.47

Northeast Corner
Section 5-2-15.
N. 245,904.20
E. 2,339,600.56

A-1 Zoning

A-4 Zoning

A-1 Zoning

A-4 Zoning

A-1 Zoning

East 1/4 Corner
Section 5-2-15.
N. 243,273.13
E. 2,339,575.94

State Trunk Highway 89 (90' Wide)


Plat of Survey

of


Lot 1 of Certified Survey Map No. 4367,

recorded in Vol. 28 of Certified Survey Maps of Walworth County
on Page 162 and located in the Northeast 1/4 of Section 5, Town 2
North, Range 15 East, Town of Darien, Walworth County, Wisconsin.

Surveyed for: **Midamerica Holdings, LLP**
P.O. Box 570
Clinton, Wisconsin. 53525

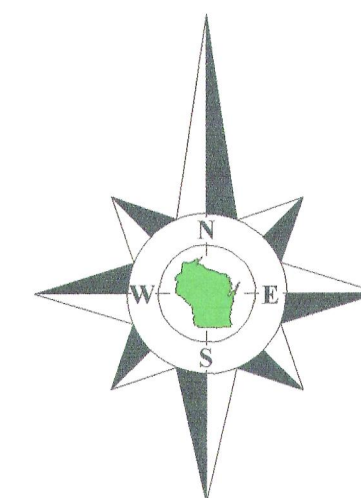

Bearings reference to the Wisconsin State
Plane Coordinate System, South Zone.

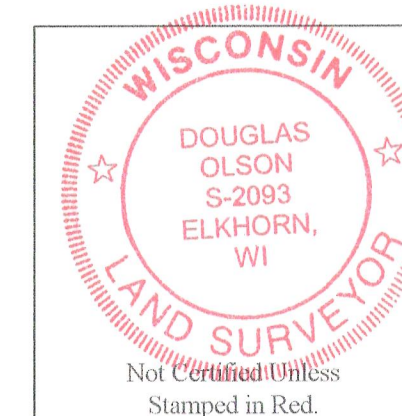

Notes:

- 1) This survey plat is not certified unless signed and sealed in red ink.
- 2) This survey is subject to Wisconsin lien laws. This Plat of Survey is the notice of intent to file lien. Lien waiver required.



Copyright 2011 by Jensen & Olson Land Surveying, LLC.

All rights reserved. No part of this survey plat may be reproduced or transmitted in any form by any means - graphic, electronic, or mechanical, including photocopying, tracing, or information storage and retrieval systems - without permission in writing from Douglas G. Olson, Jensen & Olson Land Surveying, LLC.

I hereby certify that I have surveyed the above described property and the map hereon is correct to the best of my professional knowledge and belief and shows the size and location of the property, its exterior boundaries, the location and dimensions of all visible structures thereon, boundary fences, apparent easements and roadways and visible encroachments, if any.

This survey is made for the exclusive use of the present owners of the property, and also those who purchase, mortgage or guarantee title thereto, within one year from the date hereof.

Douglas G. Olson
Wisconsin Registered Land Surveyor - 2093

Note:


** Manhole covers on site appear to be some type of private storm sewer system.

Tax Parcel
BD 500001

BA4367-1

215-723

Survey Date: August 9, 2011.
Revisions:

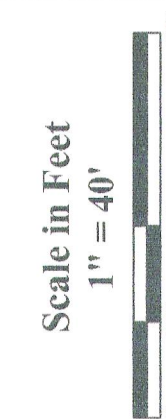

Jensen & Olson Land Surveying, LLC
45 South Wisconsin Street * P.O. Box 322 * Elkhorn, Wisconsin. 53121
Telephone: (262) 723-3434 * Facsimile: (262) 723-8044
Email: jensen.olson@elknet.net

Legend
Found County Section Corner
Found Road
Found R.O.W. Post
Recorded Information
Utility Pole
Utility Pedestal
Manhole **
Asphalt Surface
Concrete Surface
Concrete Cover
Gravel

Sheet 1 of 1 Sheets
Drawing Name: Qm15c-2011003-2011003Plat.sld
Job Reference Number
2011.003

2011.003