Reference Number 2019.043 Sheets

2019.043

of


Plat of Survey

Lots 6 and 7 of the Annex to Inlet Oaks,

a subdivision located in the Northeast 1/4 of the Northeast 1/4 of Section 22, Town 2 North, Range 16 East, Town of Delavan, Walworth County, Wisconsin.

Surveyed for: Keefe Real Estate, Inc.

416 Bauer Parkway Delavan, Wisconsin. 53115

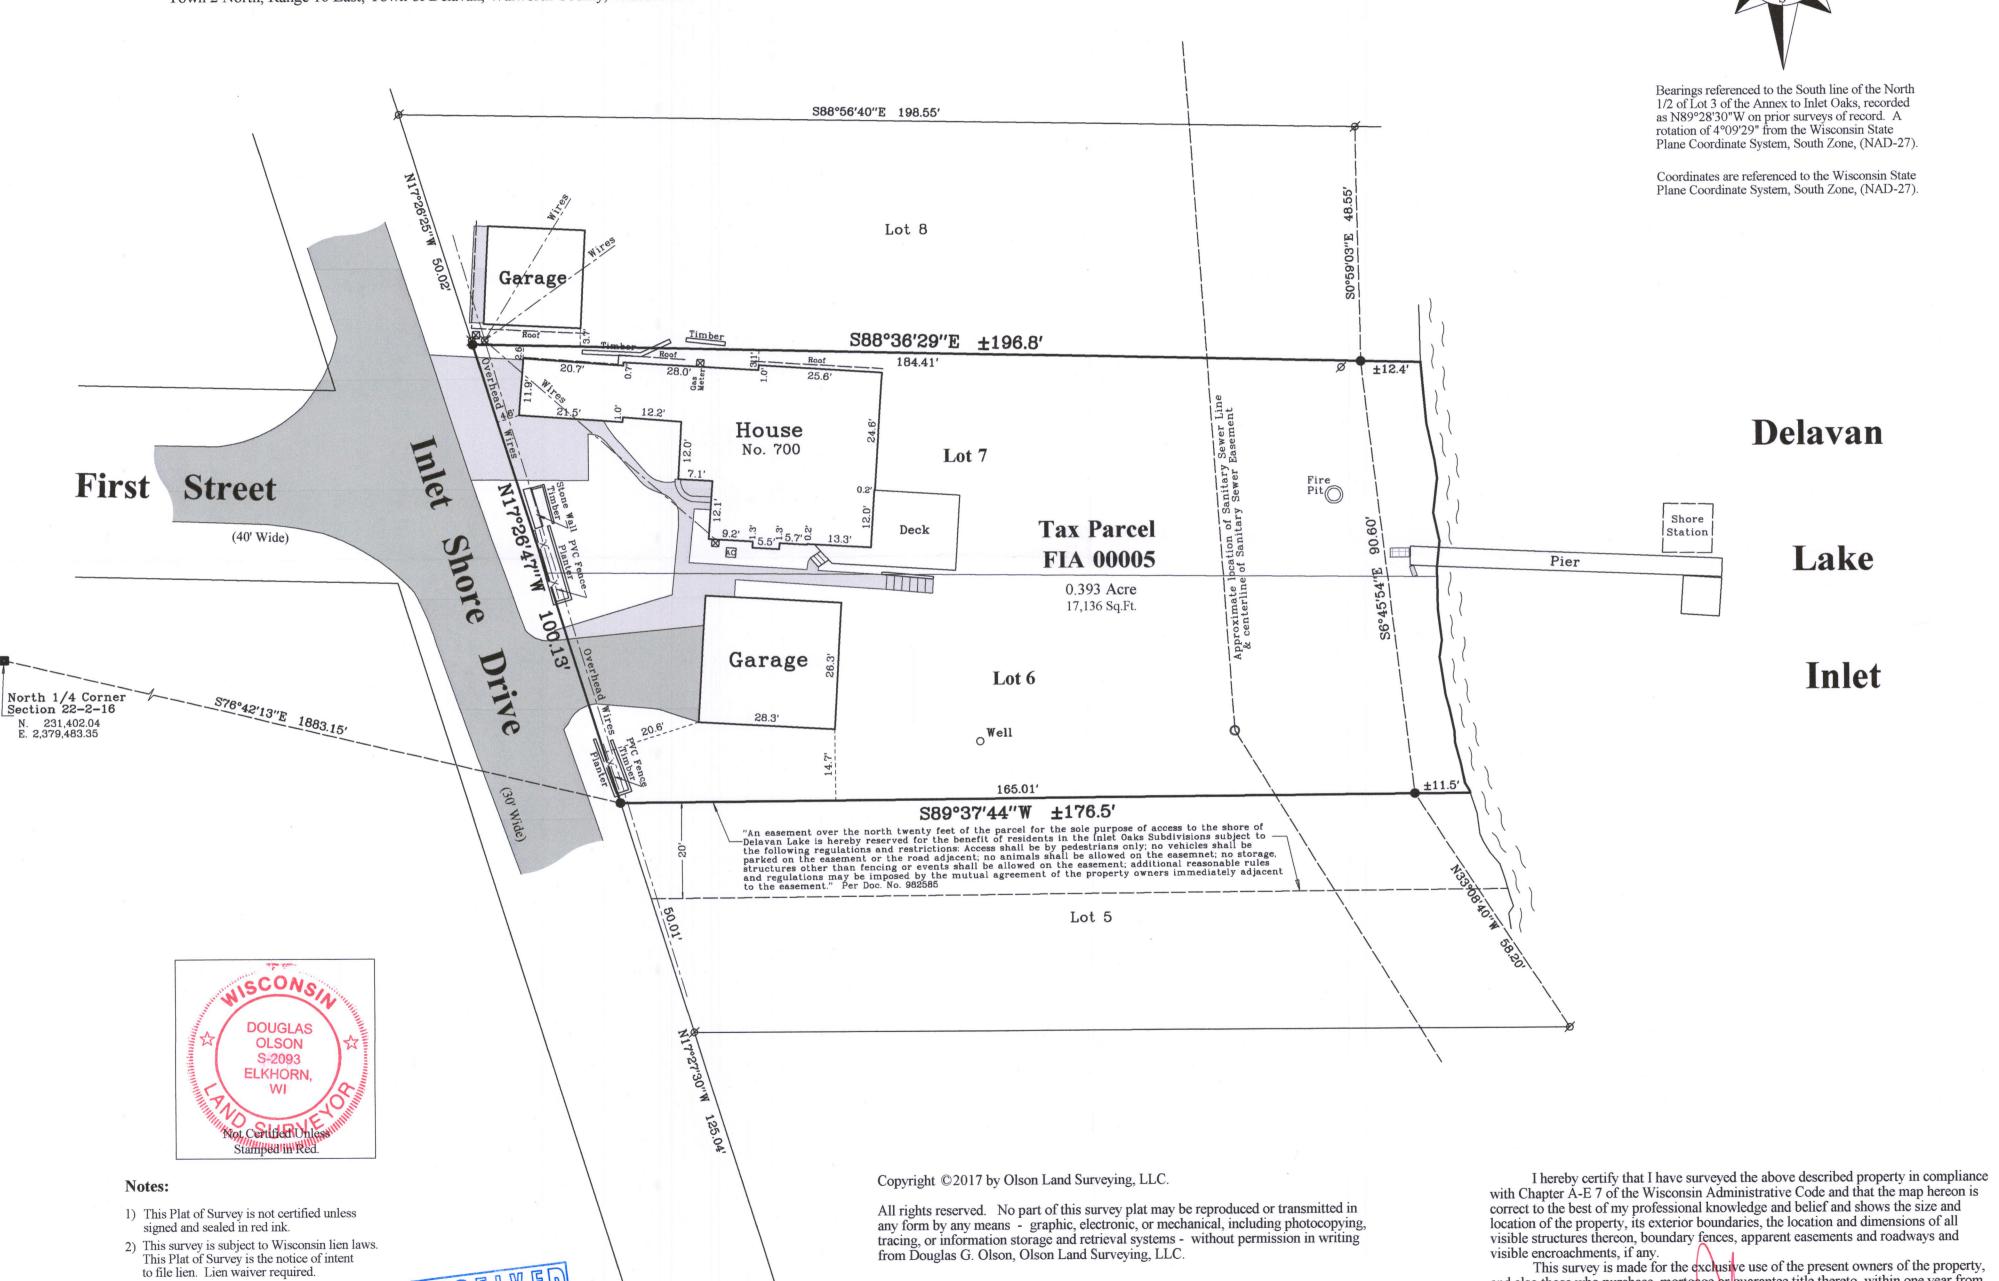

3) The Survey Date shown on this Plat of Survey is the completion date of the field work.

FIA-5

Douglas G. Olson Wisconsin Professional Land Surveyor - 2093

from Douglas G. Olson, Olson Land Surveying, LLC.

215-817

visible encroachments, if any.

This survey is made for the exclusive use of the present owners of the property, and also those who purchase, mortgage or guarantee title thereto, within one year from

the date hereof.