


DUNHAM SURVEYING, S.C.
SURVEYING & SUBDIVIDING
DELAVER, WISCONSIN 53115

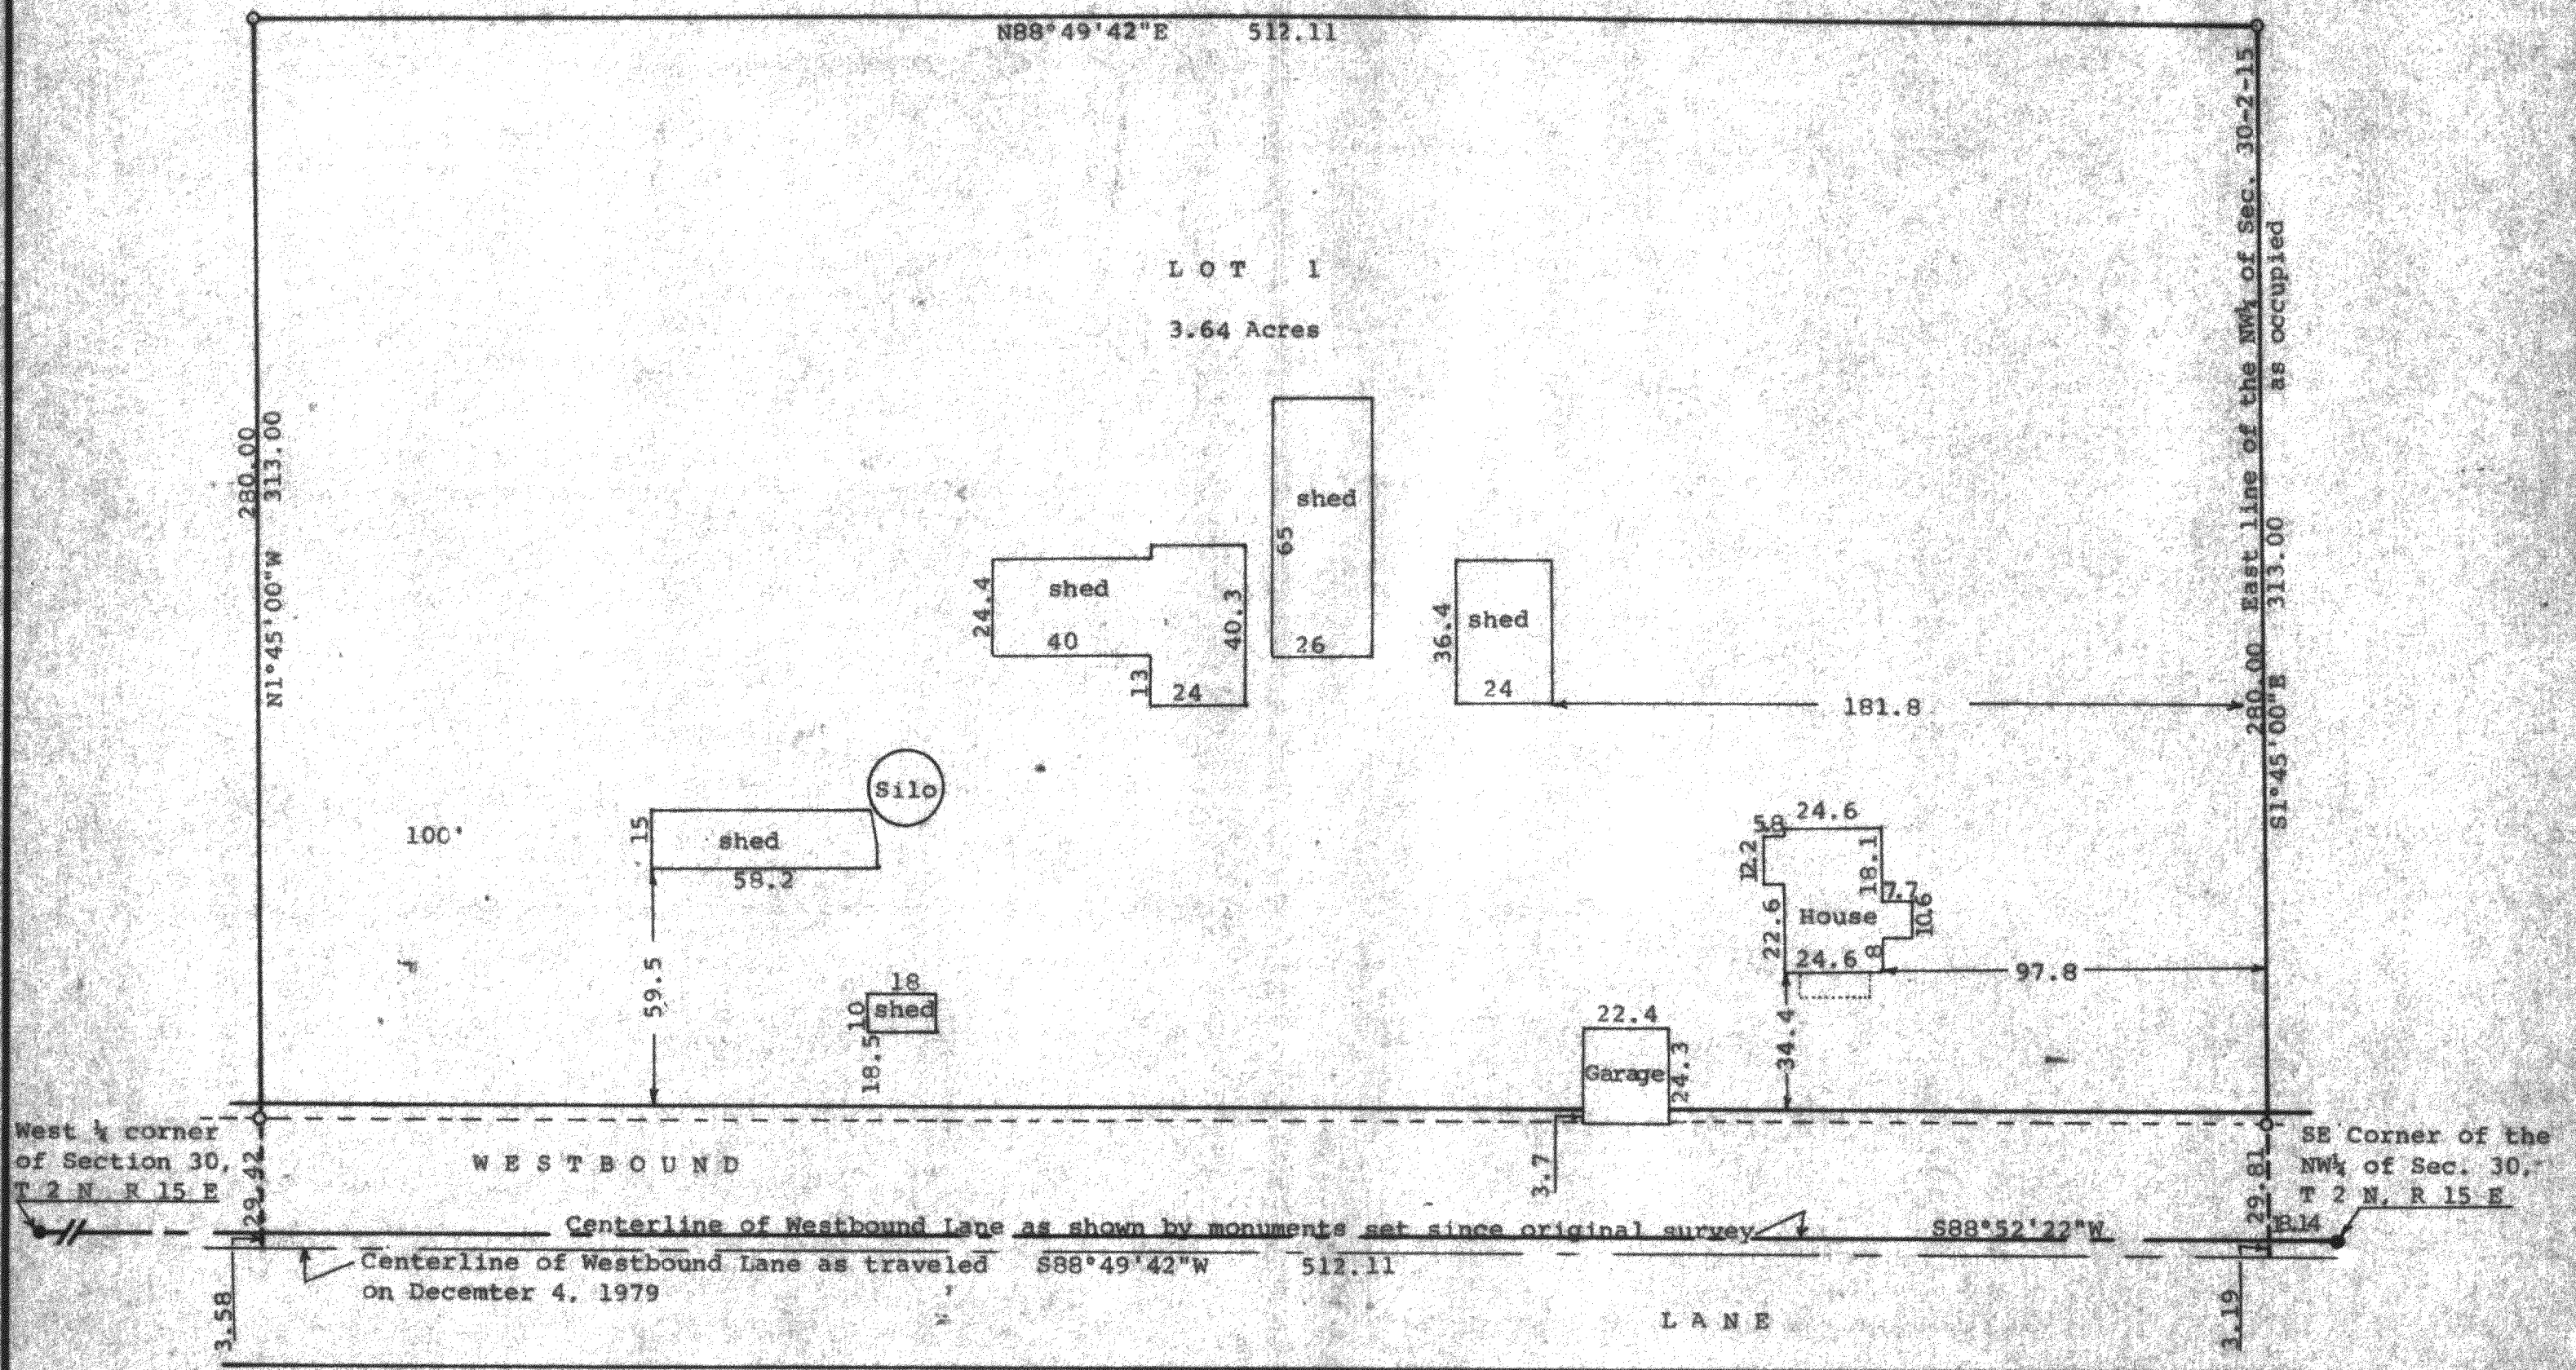



Scale - 1" = 40'
● = Concrete Monument
○ = 1" Iron Pipe Found
Bearings are those on the recorded plat
of Certified Survey No. 987
Survey ordered by: The Rauland Agency
118 Kenosha
Walworth, WI 53184

STATE OF WISCONSIN
COUNTY OF WALWORTH

I, George T. Dunham, Surveyor, certify that I have surveyed the
property described as follows:

Lot 1 of Certified Survey No. 987, recorded in Volume 4 of
Certified Surveys on Page 254, in the Office of the Register
of Deeds, Document No. 54331, on December 14, 1979, Elkhorn,
Wisconsin, being a parcel of land located in the Northwest 1/4
of Section 30, T 2 N, R 15 E, Walworth County, Wisconsin,
and that the plat shown hereon is a correct representation thereof and shows
the size and location of the property, its exterior boundaries, the location
of all visible structures and dimensions of all principal buildings thereon,
boundary fences, apparent easements, roadways and visible encroachments, if
any, and that I have surveyed the property hereondescribed, according to the
official records, to the best of my knowledge and belief.
June 15, 1993

George T. Dunham
George T. Dunham, Surveyor

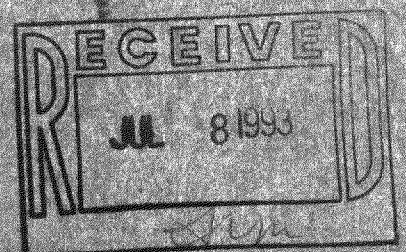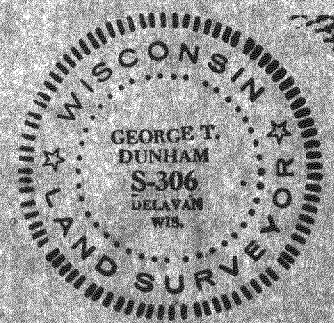

BA-987-1

215-339