





# Plat of Survey

of

## Lot 1 of Certified Survey Map No. 3400,

recorded in Vol. 19 of Certified Survey Maps of Walworth County on Page 233 and located in the Southeast 1/4 of Section 5, Town 2 North, Range 15 East, Town of Darien, Walworth County, Wisconsin.

Surveyed for: **The Rauland Agency, Inc.**  
118 Kenosha Street • P.O. Box 159  
Walworth, Wisconsin. 53184

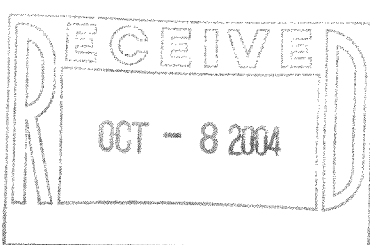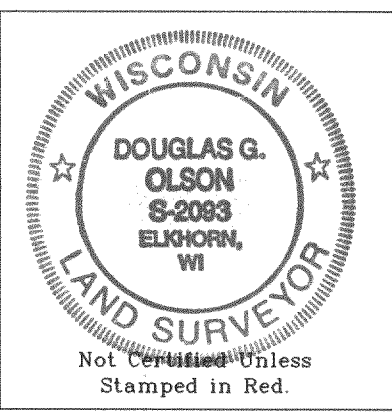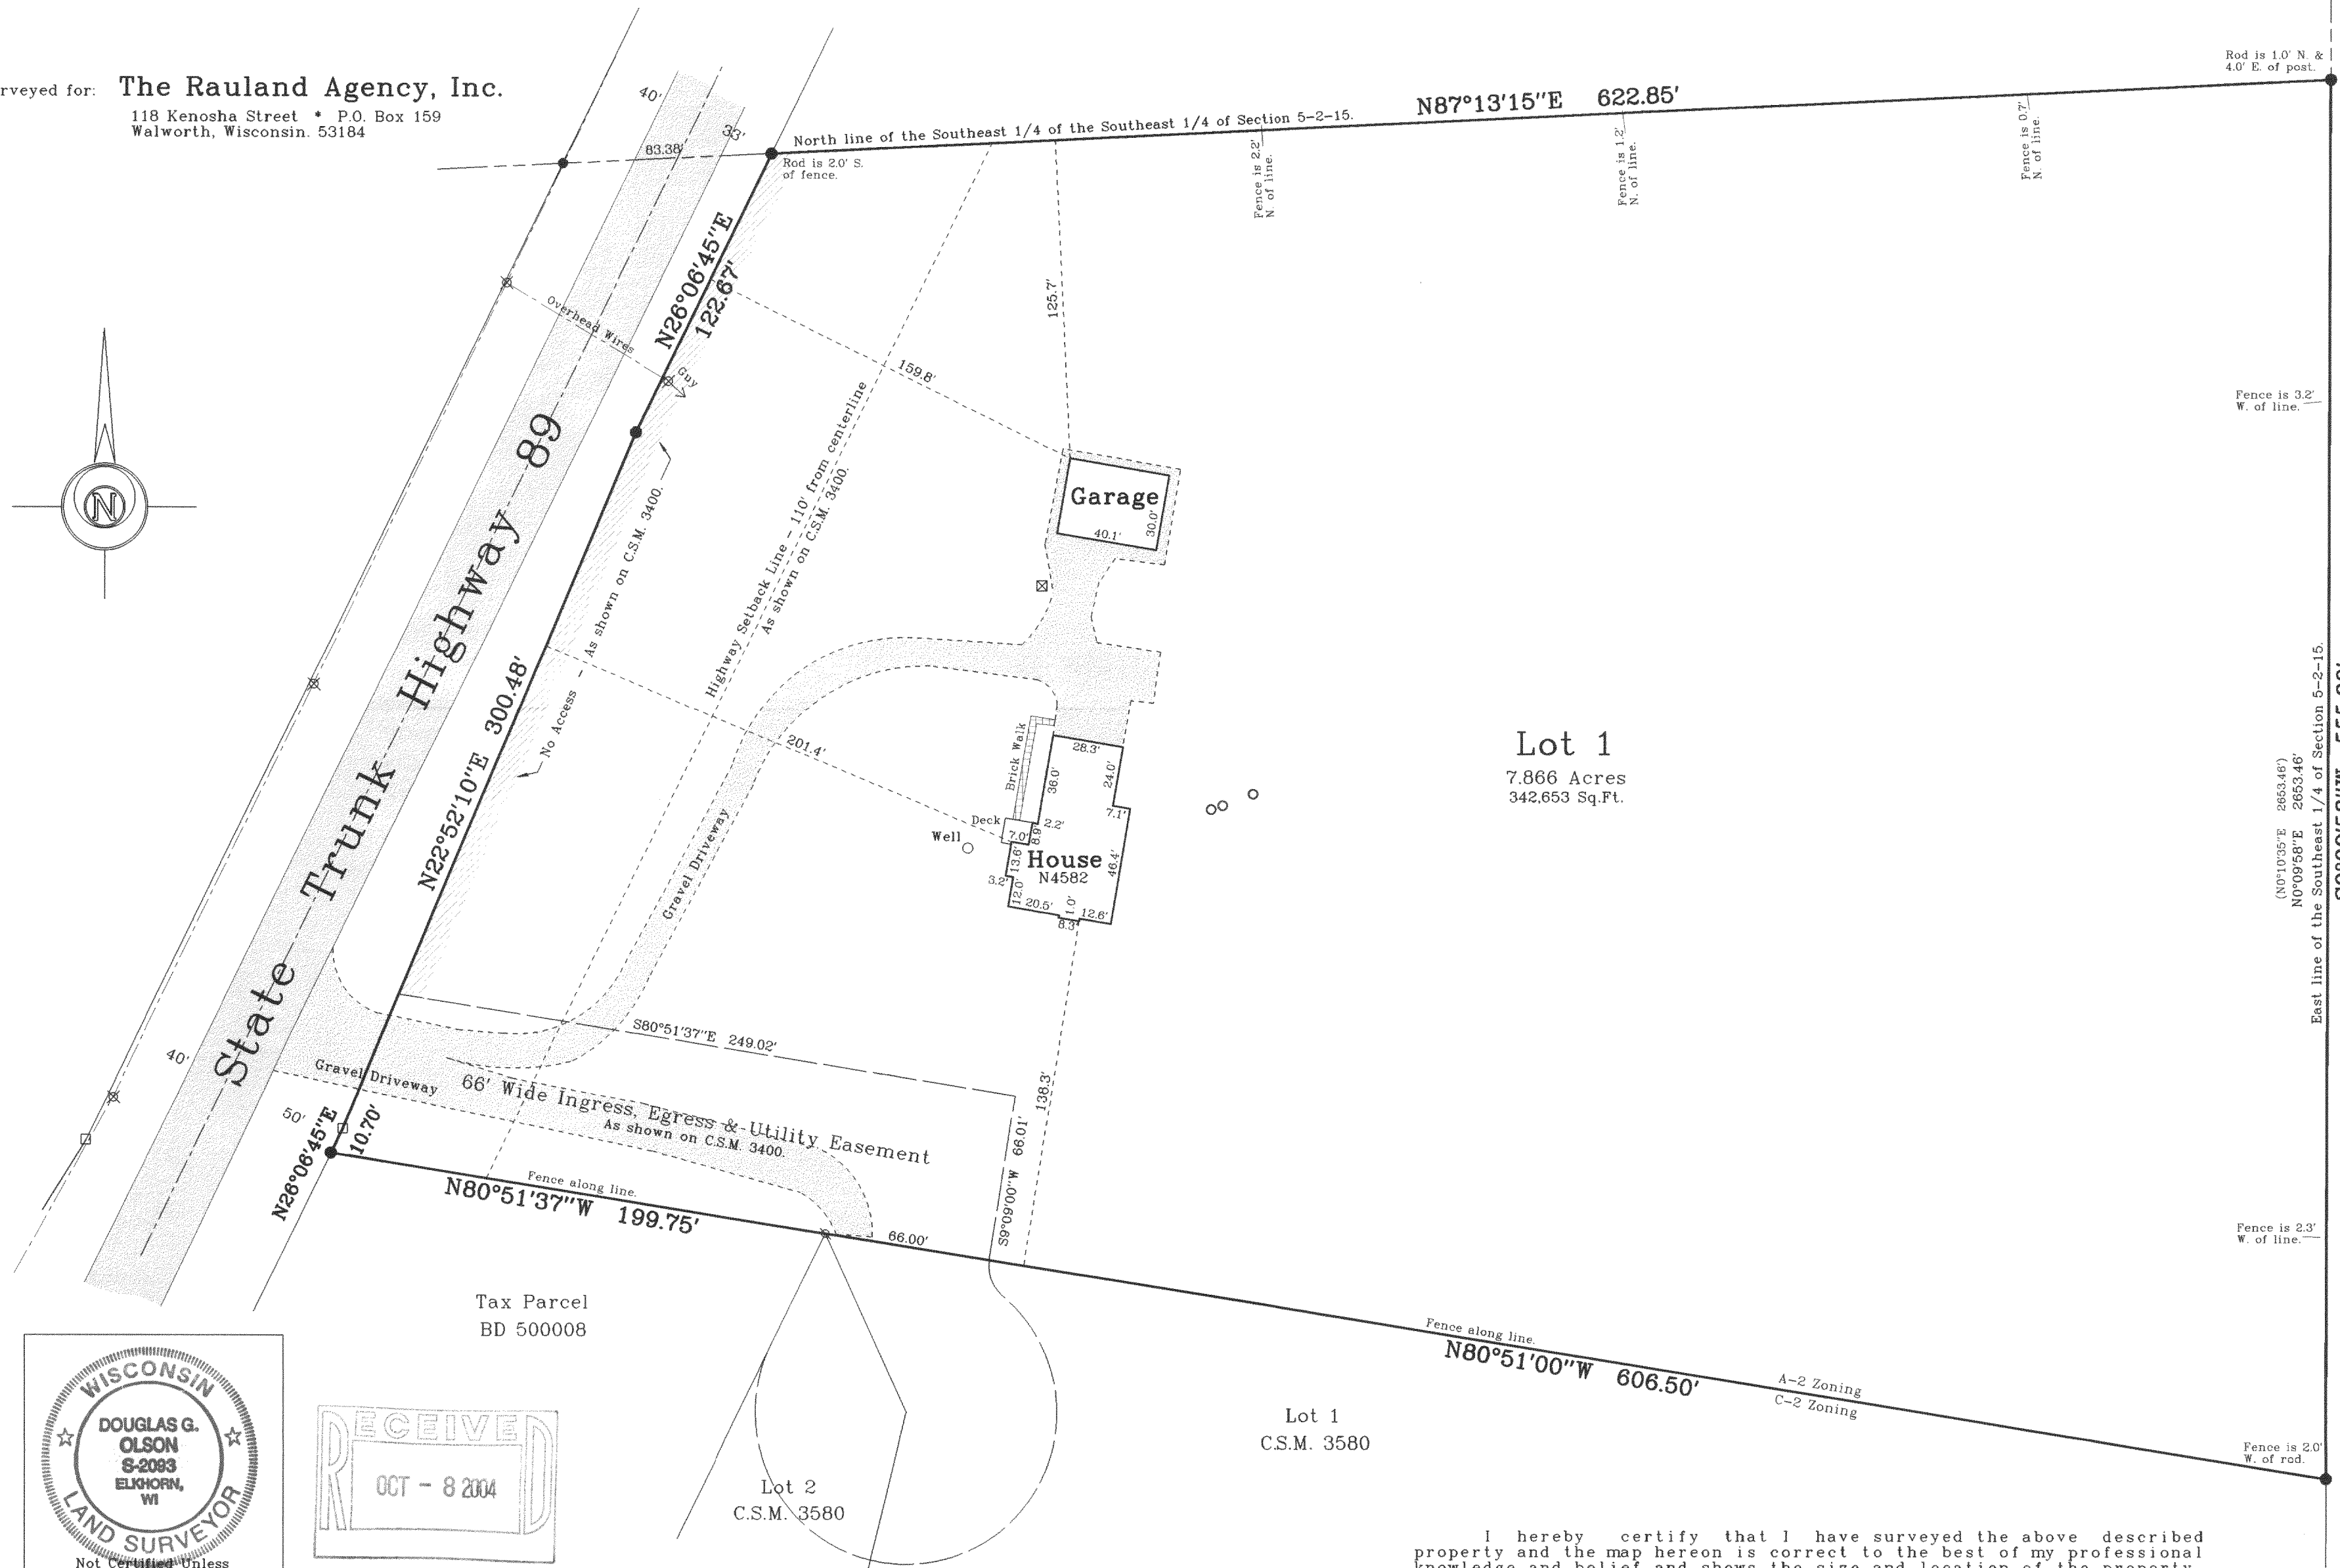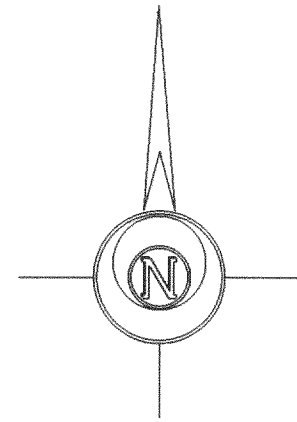

Copyright © 2004 by Jensen & Olson Land Surveying, LLC.

All rights reserved. No part of this survey plat may be reproduced or transmitted in any form by any means - graphic, electronic, or mechanical, including photocopying, tracing, or information storage and retrieval systems - without permission in writing from Douglas G. Olson, Jensen & Olson Land Surveying, LLC.


I hereby certify that I have surveyed the above described property and the map hereon is correct to the best of my professional knowledge and belief and shows the size and location of the property, its exterior boundaries, the location and dimensions of all visible structures thereon, boundary fences, apparent easements and roadways and visible encroachments, if any.  
This survey is made for the exclusive use of the present owners of property, and also those who purchase, mortgage or guarantee title thereto, within one year from the date hereof.

Douglas G. Olson  
Wisconsin Registered Land Surveyor - 2093

Southeast Corner  
Section 5-2-15.  
(N. 240.619.64)  
(E. 2,339,567.60)

- Notes:
- 1) This survey plat is not certified unless signed and sealed in red ink.
  - 2) This survey is subject to Wisconsin lien laws. This Plat of Survey is the notice of intent to file lien. Lien waiver required.

Survey Date: May 21, 2004.  
Revisions:

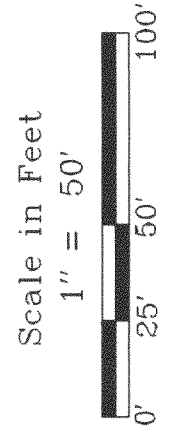

**Jensen & Olson Land Surveying, LLC**  
45 South Wisconsin Street P.O. Box 322  
Elkhorn, Wisconsin 53121  
Telephone (262) 723-3434  
Facsimile (262) 723-8044

- Legend
- Found County Section Corner
  - Found Iron Pipe
  - Found Iron Rod
  - Found W.D.O.T. Iron Marker
  - Recorded Information
  - Utility Pole
  - Utility Box
  - Asphalt Surface
  - Gravel Surface

Sheet 1 of 1 Sheets  
Job Reference Number  
**2004.057**  
2004.057

BA34808001

215-582