


RECEIVED
MAR 5



George F. Dunham
George F. Dunham, Surveyor

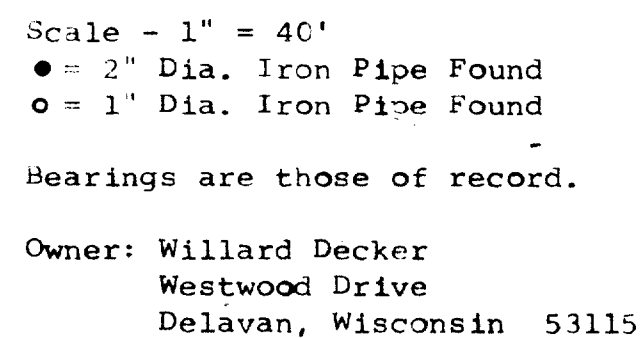