


**ABELL
SURVEYING & MAPPING
DELAVAN, WISCONSIN 53115
414-720-6757**

MIN. REAL YARD - 25'
MIN. SIDE YARD - 15'
MIN. STREET YARD SUB. RD. - 25'
MIN. STREET YARD S.T.H. - 85'

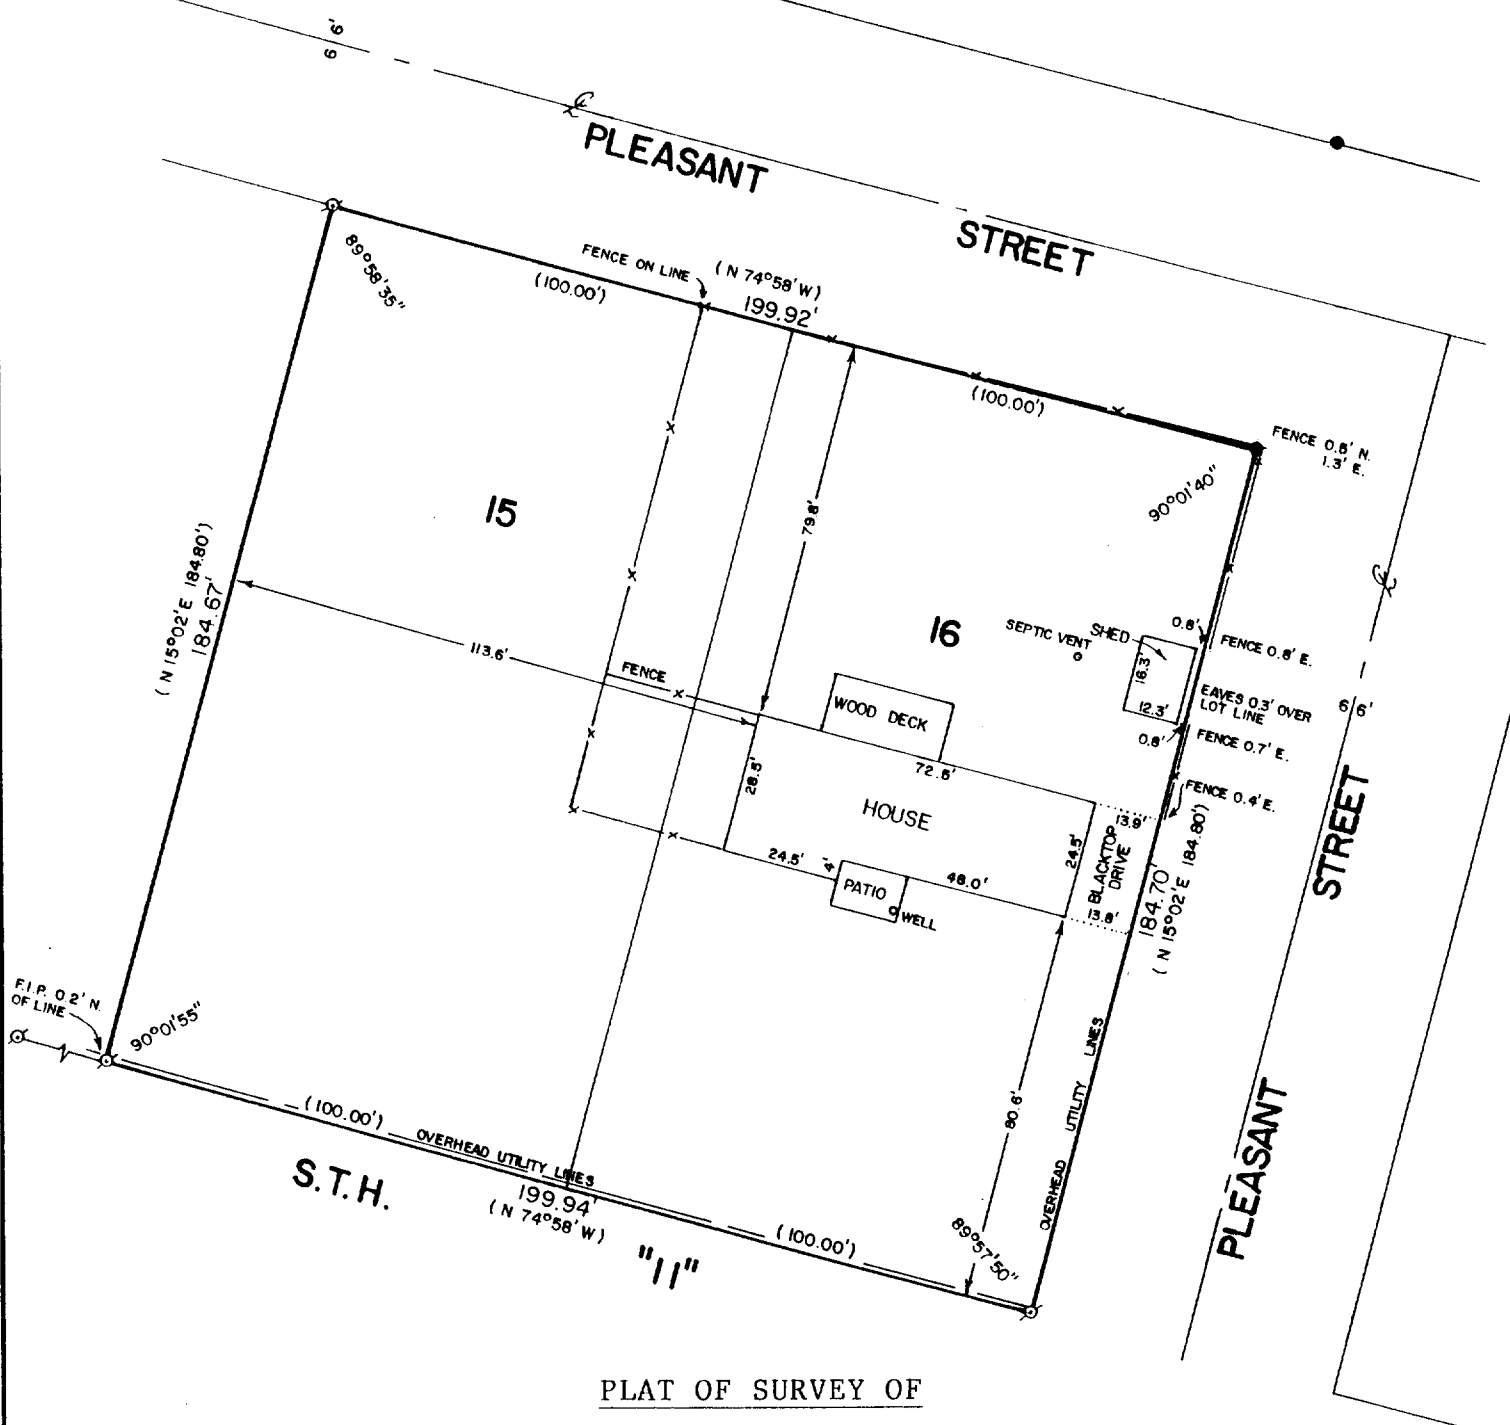


PLAT OF SURVEY OF

LOTS 15 AND 16 OF HIEMSTRA'S SUBDIVISION, LOCATED IN T2N, R15E,
WALWORTH COUNTY, WISCONSIN.

OWNER: LARRY HEINDL
RT. 2, BOX 153
DELAVAN, WI. 53115

NOTE: ON THE SUBDIVISION PLAT OF
HIEMSTRA'S SUBDIVISION, THERE IS
A BUILDING SETBACK LINE SHOWN
AS 110 FEET FROM THE CENTERLINE
OF S.T.H. "11".

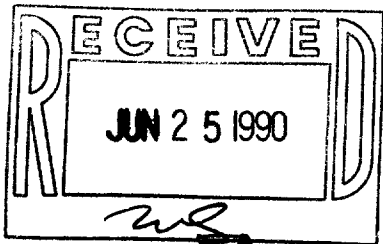

SCALE - 1"=40'

LEGEND

- ⊘ - IRON PIPE FOUND
- - CONCRETE MONUMENT FOUND
- () - RECORDED AS

I, DAVID F. ABELL, DO HEREBY CERTIFY
THAT I HAVE SURVEYED THE PROPERTY
HEREON DESCRIBED ACCORDING TO THE
OFFICIAL RECORDS AND THAT THE PLAT
HEREON IS A CORRECT REPRESENTATION
OF THE PROPERTY LINES TO THE BEST OF
MY KNOWLEDGE AND BELIEF.

David F. Abell
DAVID F. ABELL
WISCONSIN REGISTERED LAND SURVEYOR, S-1596

Tax # BHS-14
BHS-15

DATE *May 30, 1990* JOB NUMBER - 90096
NOTE: THIS IS NOT A CERTIFIED COPY UNLESS SEALED.

215-267