
## DUNHAM SERVEYING, S.C. SURVEYING & SERVINGING DELAYAN WISCONEN 53H5

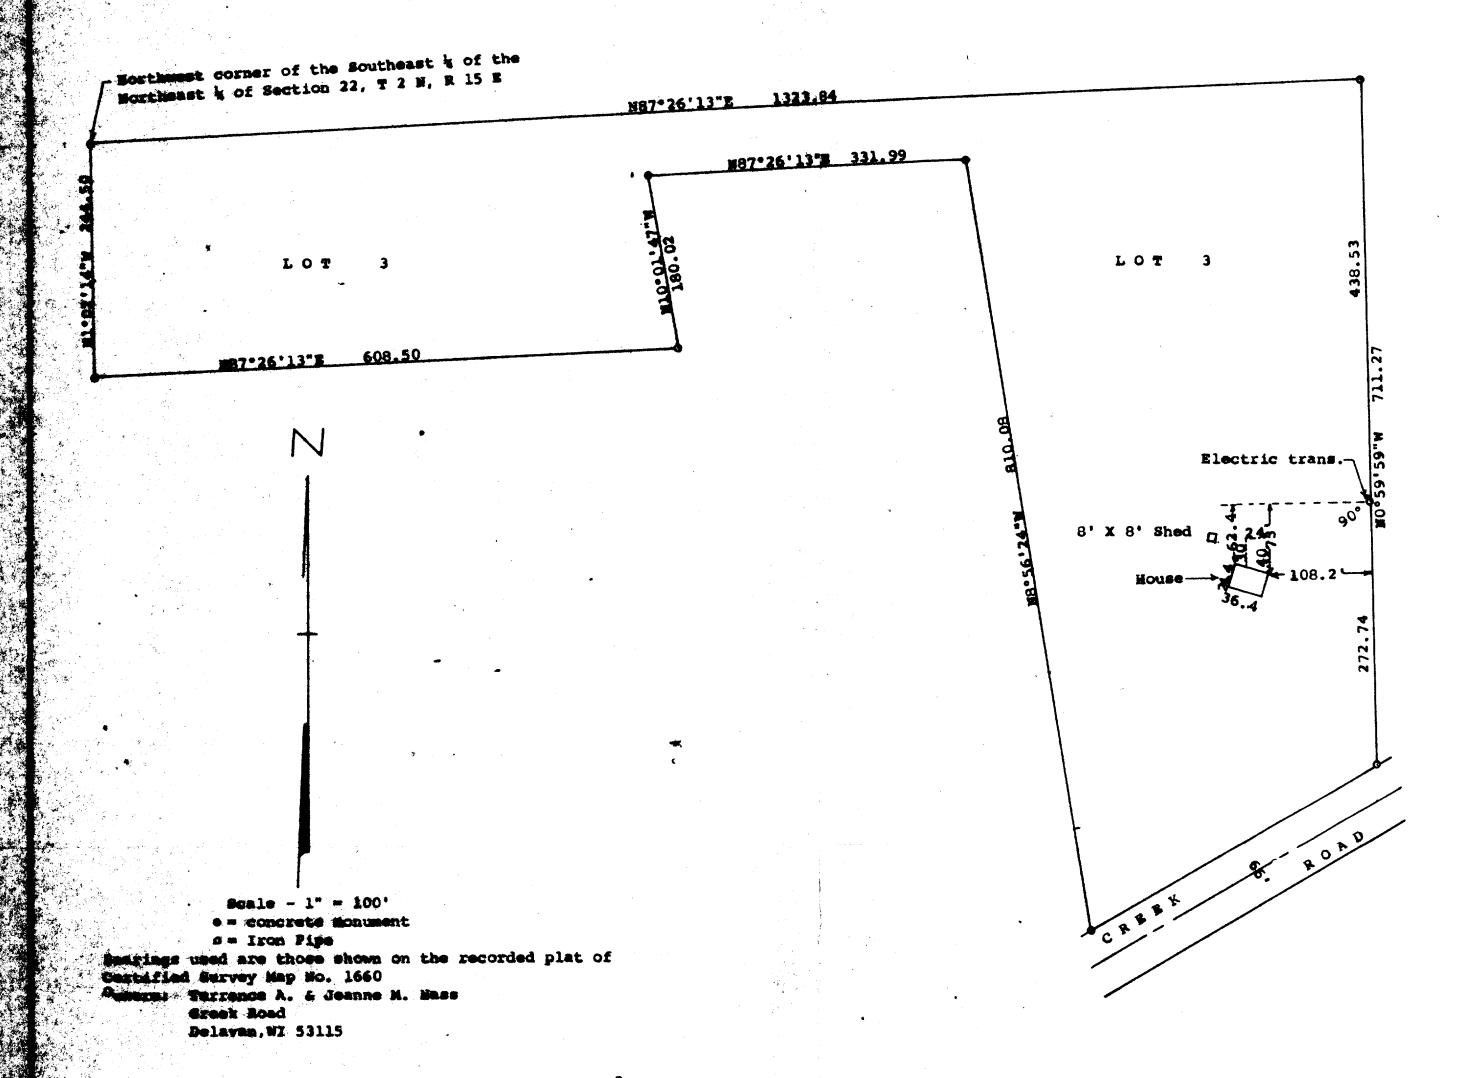

COUNTY OF WALMORTH)

I, George T. Dunham, Surveyor, certify that I have surveyed the property


described as follows:

Lot 3 of Certified Survey No. 1660, recorded in Vol. 8 of Certified Surveys on Page 15, Dogument No. 158027, on January 22, 1988, in the Office of the Register of Deeds, Blkhorn, Wisconsin, being a parcel of land located in the Southwest & of the Northeast & of Section 22, T 2 N, R 15 R, WalworthCounty, Wisconsin,

and that the plat shown hared is a correct representation thereof and shows the size and location of the property, its exterior boundaries, the location of all visible structures and dimensions of all principal buildings thereon, apparent examines, stoadways and visible encroachments, if any, and that I have surveyed the property hereon described, according to the official records, to the best of my knowledge and belief.

July 31, 1989

George fr. Dunham, Surveyor

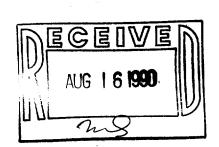



TAX KEY PAllohopodon3