

ABELL
SURVEYING & MAPPING

1140 SEQUOIA STREET • DELAVAN, WISCONSIN 53115
414-728-6737

741.90'

(N 87°51'57" E

312.03'

LOT 4

(N 2°22'03" W

105'±

HOUSE UNDER
CONSTRUCTION
1/6/99

LOT 5

(CENTERLINE OF A 30' DRAINAGE EASEMENT)

GRAVEL
DRIVE

CH=70.00'
R=70.00'
A=98.30' (98.34')
S 63°14'20" W
90.42'
90.45'

APPLEWOOD
WAY

PLAT OF SURVEY OF

PART OF LOT 5, ORCHARD RIDGE, LOCATED IN
T2N, R15E, WALWORTH COUNTY, WISCONSIN.

ORDERED BY: JUDY BECKER
W7794 APPLEWOOD WAY
DARIEN, WI 53114


N

SCALE 1"=60'

LEGEND

- ⊗ - IRON PIPE FOUND
- - UTILITY PEDS.
- () - RECORDED AS

NOTE: BEARINGS ARE REFERENCED TO THE
RECORDED SUBDIVISION PLAT.

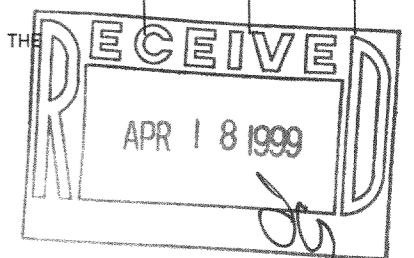

I, DAVID F. ABELL, DO HEREBY CERTIFY THAT I HAVE SURVEYED THE PROPERTY HEREON
DESCRIBED ACCORDING TO THE OFFICIAL RECORDS AND THAT THE PLAT HEREON IS A
CORRECT REPRESENTATION OF THE PROPERTY LINES TO THE BEST OF MY KNOWLEDGE AND
BELIEF.

David F. Abell

DAVID F. ABELL
WISCONSIN REGISTERED LAND SURVEYOR, S-1596

January 10, 1999

DATE: January 10, 1999 JOB NUMBER - 99003
NOTE: THIS IS NOT A CERTIFIED COPY UNLESS SEALED.

214.39'

(S 0°58'07" E

6 6'

'K'

C.T.H.

BOR-5

215-458