

NOTE 1: BEARINGS ARE REFERENCED TO THE
RECORDED SUBDIVISION PLAT.

1140 SEQUOIA STREET • DELAVAN, WISCONSIN 53115
262-728-6737



NOTE 3: ON THE SUBDIVISION PLAT OF
HIEMSTRA'S SUBDIVISION, THERE IS
A BUILDING SETBACK LINE SHOWN
AS 110 FEET FROM THE CENTERLINE
OF S.T.H. "11".

LOTS 15 AND 16 OF HIEMSTRA'S SUBDIVISION, LOCATED
IN T2N, R15E, WALWORTH COUNTY, WISCONSIN.



SCALE 1" = 30'

LEGEND

- ♂ - IRON PIPE FOUND
 ■ - CONCRETE MONUMENT FOUND
 BE - BASEMENT ENTRY
 ----- - CHAINLINK FENCE
 () - RECORDED AS

I HEREBY CERTIFY THAT I HAVE SURVEYED THE ABOVE DESCRIBED PROPERTY AND THAT THE ABOVE MAP IS A TRUE REPRESENTATION THEREOF AND SHOWS THE SIZE AND LOCATION OF THE PROPERTY, ITS EXTERIOR BOUNDARIES, THE LOCATION OF ALL VISIBLE STRUCTURES AND DIMENSIONS OF ALL PRINCIPAL BUILDINGS THEREON, BOUNDARY FENCES, APPARENT EASEMENTS, ROADWAYS AND VISIBLE ENCROACHMENTS, IF ANY, TO THE BEST OF MY KNOWLEDGE AND BELIEF.

THIS SURVEY IS MADE FOR THE USE OF THE PRESENT OWNERS OF THE PROPERTY, AND ALSO THOSE WHO PURCHASE, MORTGAGE, OR GUARANTEE THE TITLE THERETO WITHIN ONE (1) YEAR FROM DATE HEREON.


Daniel F. Rhall

DAVID F. ABELL
WISCONSIN REGISTERED LAND SURVEYOR, S-1596

October 17, 2002

DATE _____ JOB NUMBER - 90096A

NOTE: THIS IS NOT A CERTIFIED COPY UNLESS SEALED.

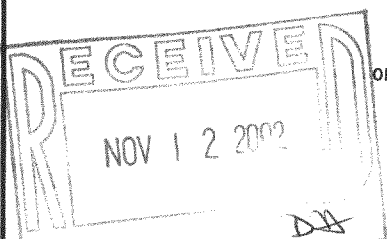

ORDERED BY: LARRY HEINDL
W7503 PLEASANT STREET
DELAVER, WI 53115

October 17, 2002

DATE _____ JOB NUMBER - 90096A
NOTE: THIS IS NOT A CERTIFIED COPY UNLESS SEALED.

✓ BHS-15

215-523