





WORK ORDERED BY:  
GREENWOOD SHORES, LLC  
1818 HOBBS DRIVE  
DELAVAN, WI. 53115


FARRIS, HANSEN & ASSOCIATES, INC.  
ENGINEERING - ARCHITECTURE - SURVEYING  
7 RIDGWAY COURT P.O. BOX 437  
ELKHORN, WISCONSIN 53121  
OFFICE: (262) 723-2098 FAX: (262) 723-5886

REVISIONS

PROJECT NO.  
8208  
DATE:  
08-12-2010  
SHEET NO.  
1 OF 1

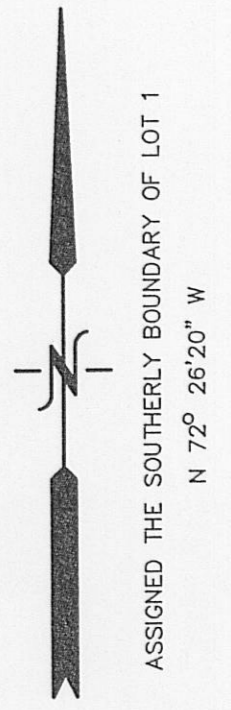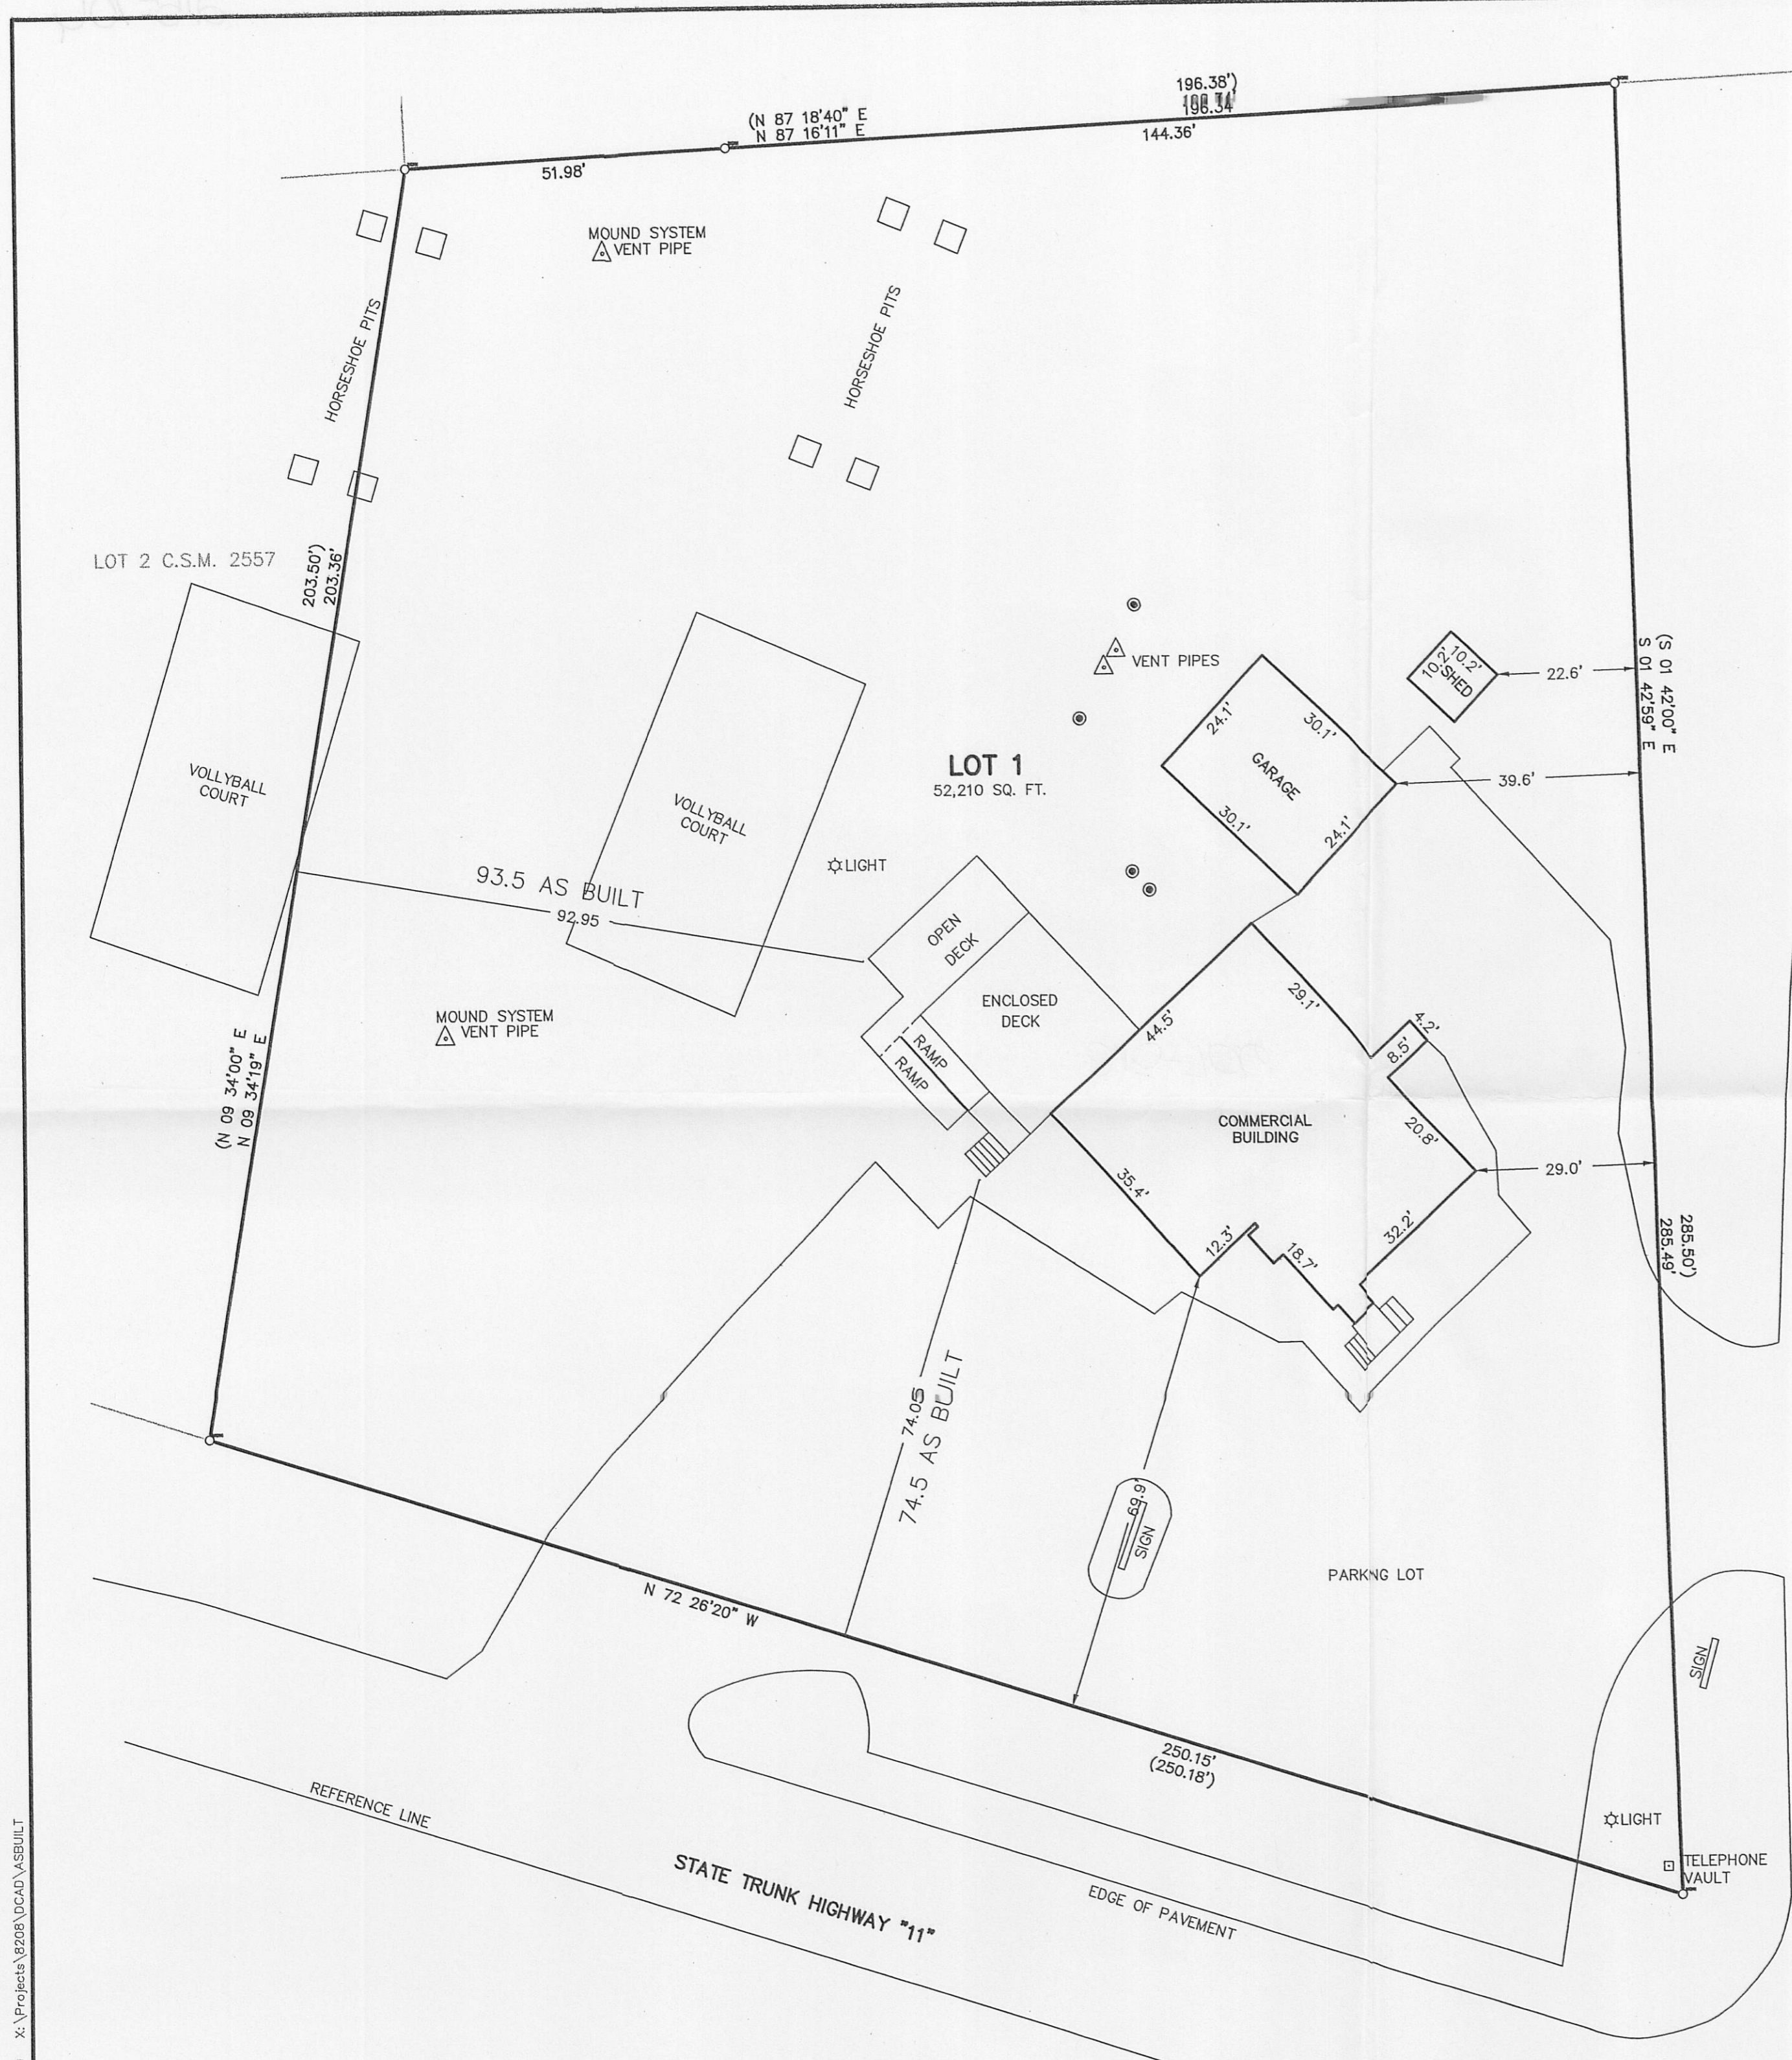


- LEGEND
- -FOUND IRON PIPE STAKE
  - (XXX)-RECORDED AS
  - -CONCRETE SEPTIC COVER

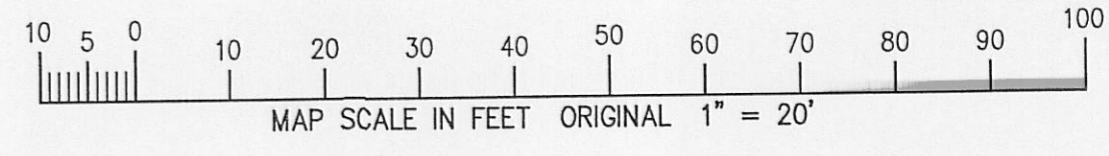

RECEIVED  
FEB 16 2011  
By *JMG*

NOTE: COPIES OF THIS MAP TO WHICH THE FOLLOWING CERTIFICATE WILL APPLY SHOW THE SURVEYOR'S ORIGINAL SEAL AND SIGNATURE IN RED INK. COPIES BY ANY OTHER MEANS MAY HAVE ALTERATIONS WHICH DO NOT REPRESENT THE SURVEYOR'S WORK PRODUCT.

I HEREBY CERTIFY THAT THE ABOVE DESCRIBED PROPERTY HAS BEEN SURVEYED UNDER MY DIRECTION AND THAT THE ABOVE MAP IS A TRUE REPRESENTATION THEREOF AND SHOWS THE SIZE AND LOCATION OF THE PROPERTY AND ITS EXTERIOR BOUNDARIES. THIS SURVEY IS MADE FOR THE USE OF THE PRESENT OWNERS OF THE PROPERTY, AND ALSO THOSE WHO PURCHASE, MORTGAGE, OR GUARANTEE THE TITLE THERETO WITHIN ONE YEAR FROM THE DATE HEREOF.

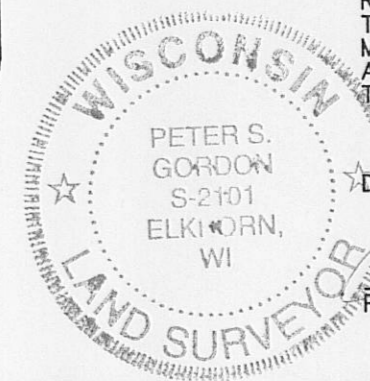

DATED: 8/12/2010  
PETER S. GORDON R.L.S. 2101

REVISED 12-29-2010  
TO SHOW AS BUILT NEW DECK AND RAMP

215-706