
PLAT OF SURVEY

PATHFINDER SURVEYING INC. (formerly) J.K. SURVEYING INC. P.O BOX 322 LAKE GENEVA, WI. 53147

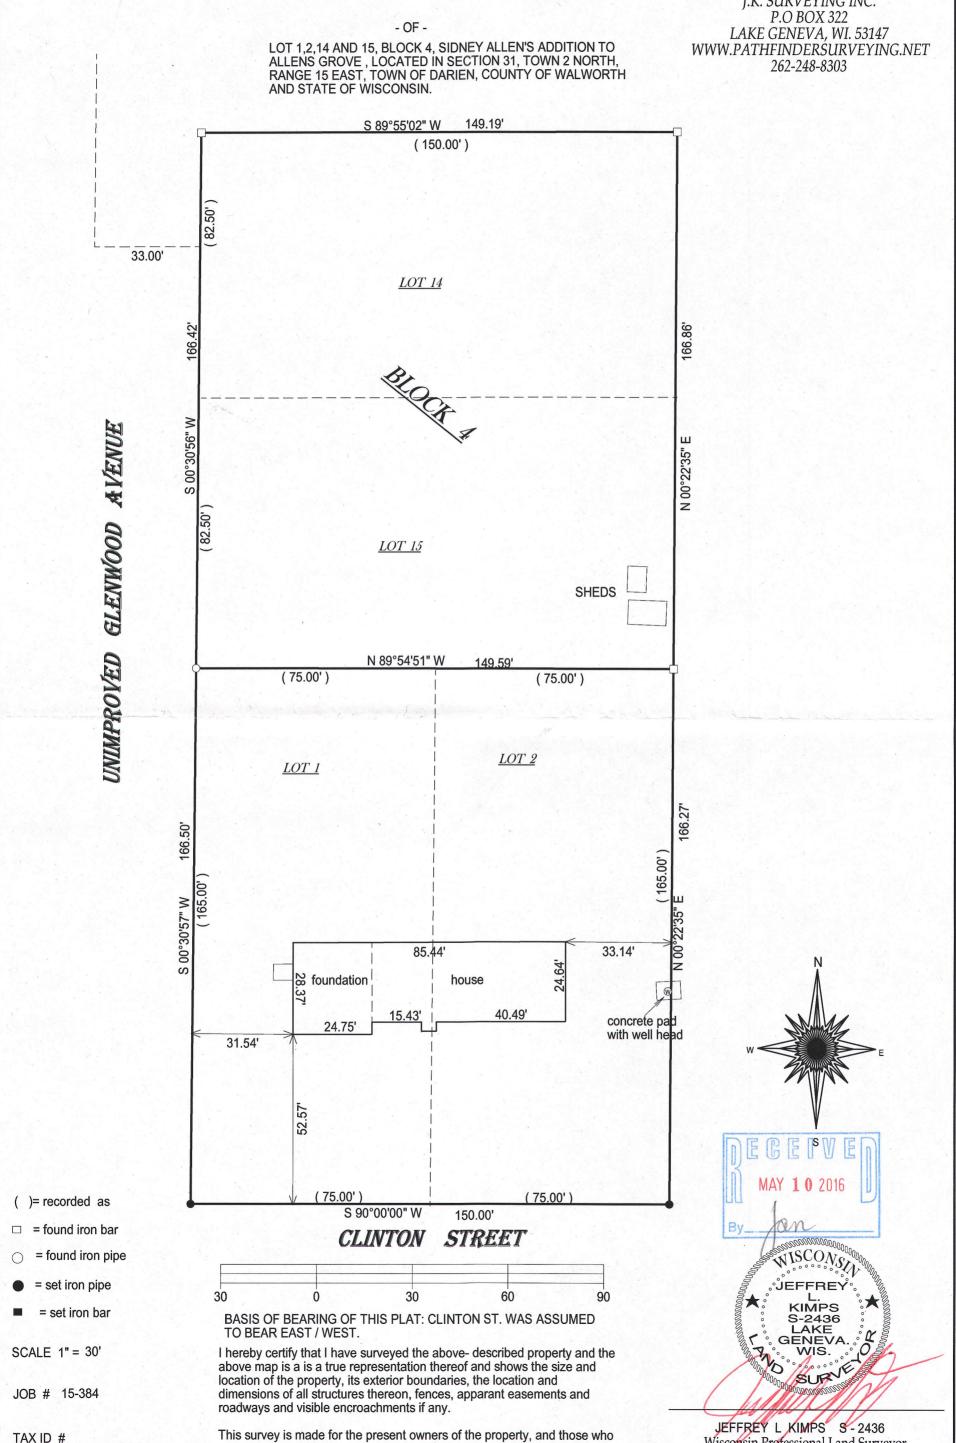

This survey is made for the present owners of the property, and those who purchase, mortgage, or guarantee the title thereto, within one year from DATED THIS 20TH DAY OF DECEMBER, 2015.

BAGV 00013B / 00013B1

JEFFREY L KIMPS S-2436 Wisconsin Professional Land Surveyor (original if signed in red)