



ABELL
SURVEYING & MAPPING
DELAVER, WISCONSIN 53115
414-728-6737

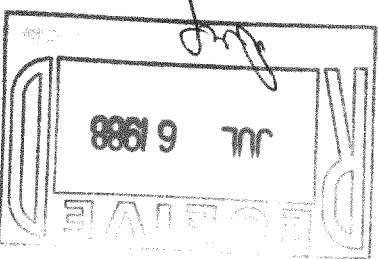

SCHROEDER AVENUE

BALL PARK AVE.

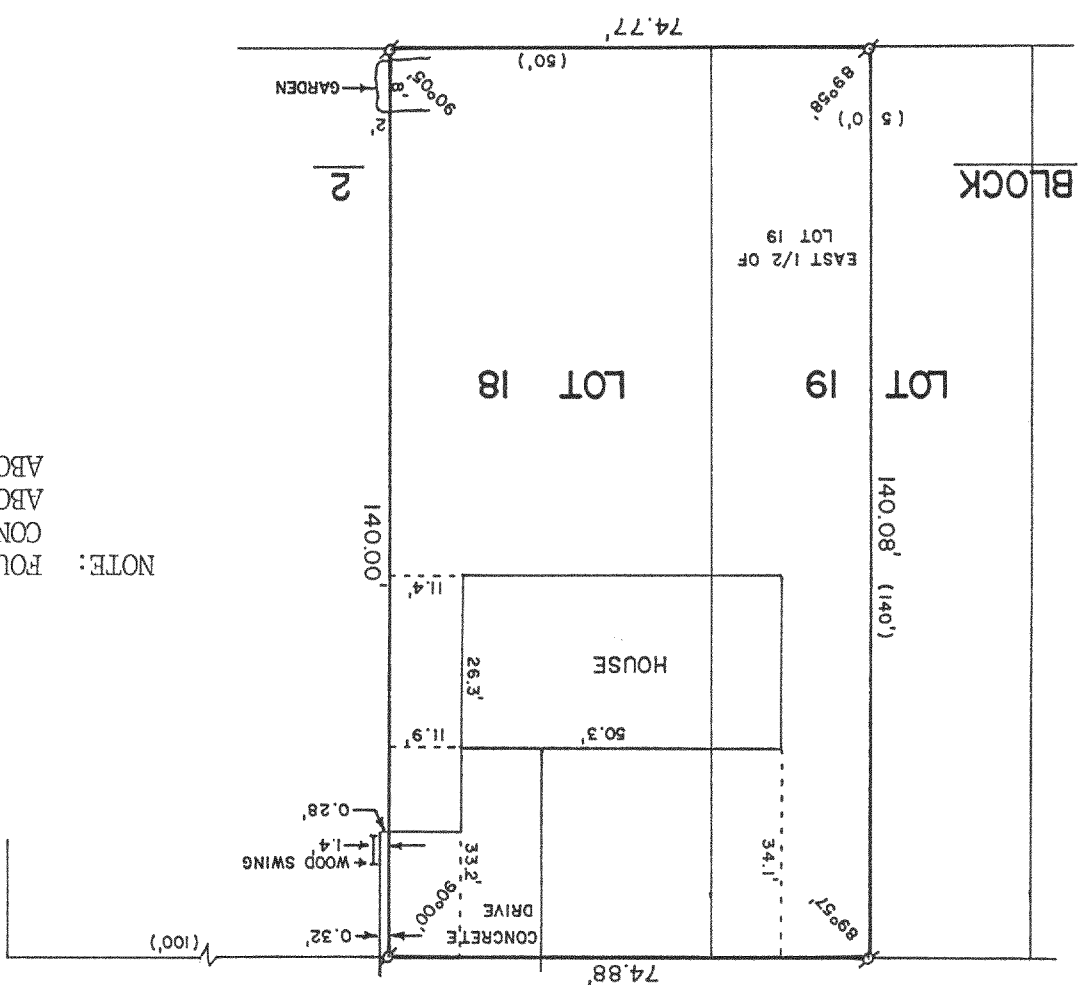

PLAT OF SURVEY OF
LOT 18 AND THE EAST 1/2 OF LOT 19, BLOCK 2, INLET OAKS
SUBDIVISION NO. 4, T2N, R16E, WATWORTH COUNTY, WISCONSIN.
ORDERED BY: VACATION PROPERTIES NETWORK
159 BROAD STREET
LAKE GENEVA, WI. 53147

I, DAVID F. ABELL, DO HEREBY CERTIFY
THAT I HAVE SURVEYED THE PROPERTY
HEREON DESCRIBED ACCORDING TO THE
OFFICIAL RECORDS AND THAT THE PLAT
HEREON IS A CORRECT REPRESENTATION
OF THE PROPERTY LINES TO THE BEST OF
MY KNOWLEDGE AND BELIEF.

SCALE - 1"=30'
LEGEND
- IRON PIPE FOUND
() - RECORDED AS



DAVID F. ABELL
David F. Abell
June 20, 1988
JOB NUMBER - 88120

NOTE: THIS IS NOT A CERTIFIED COPY UNLESS SEALED.
DATE

WISCONSIN REGISTERED LAND SURVEYOR, S-1596

211-1028