



**ABELL
SURVEYING & MAPPING**
DELAVAN, WISCONSIN 53115
414-728-6737

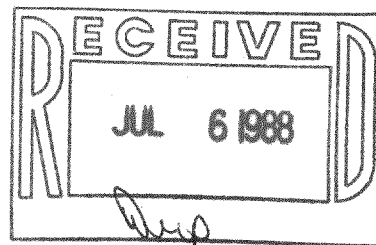


ORDERED BY: CENTURY 21 - SKANDIA
REALTY
312 S. 7th STREET
DELAVAN, WI. 53115

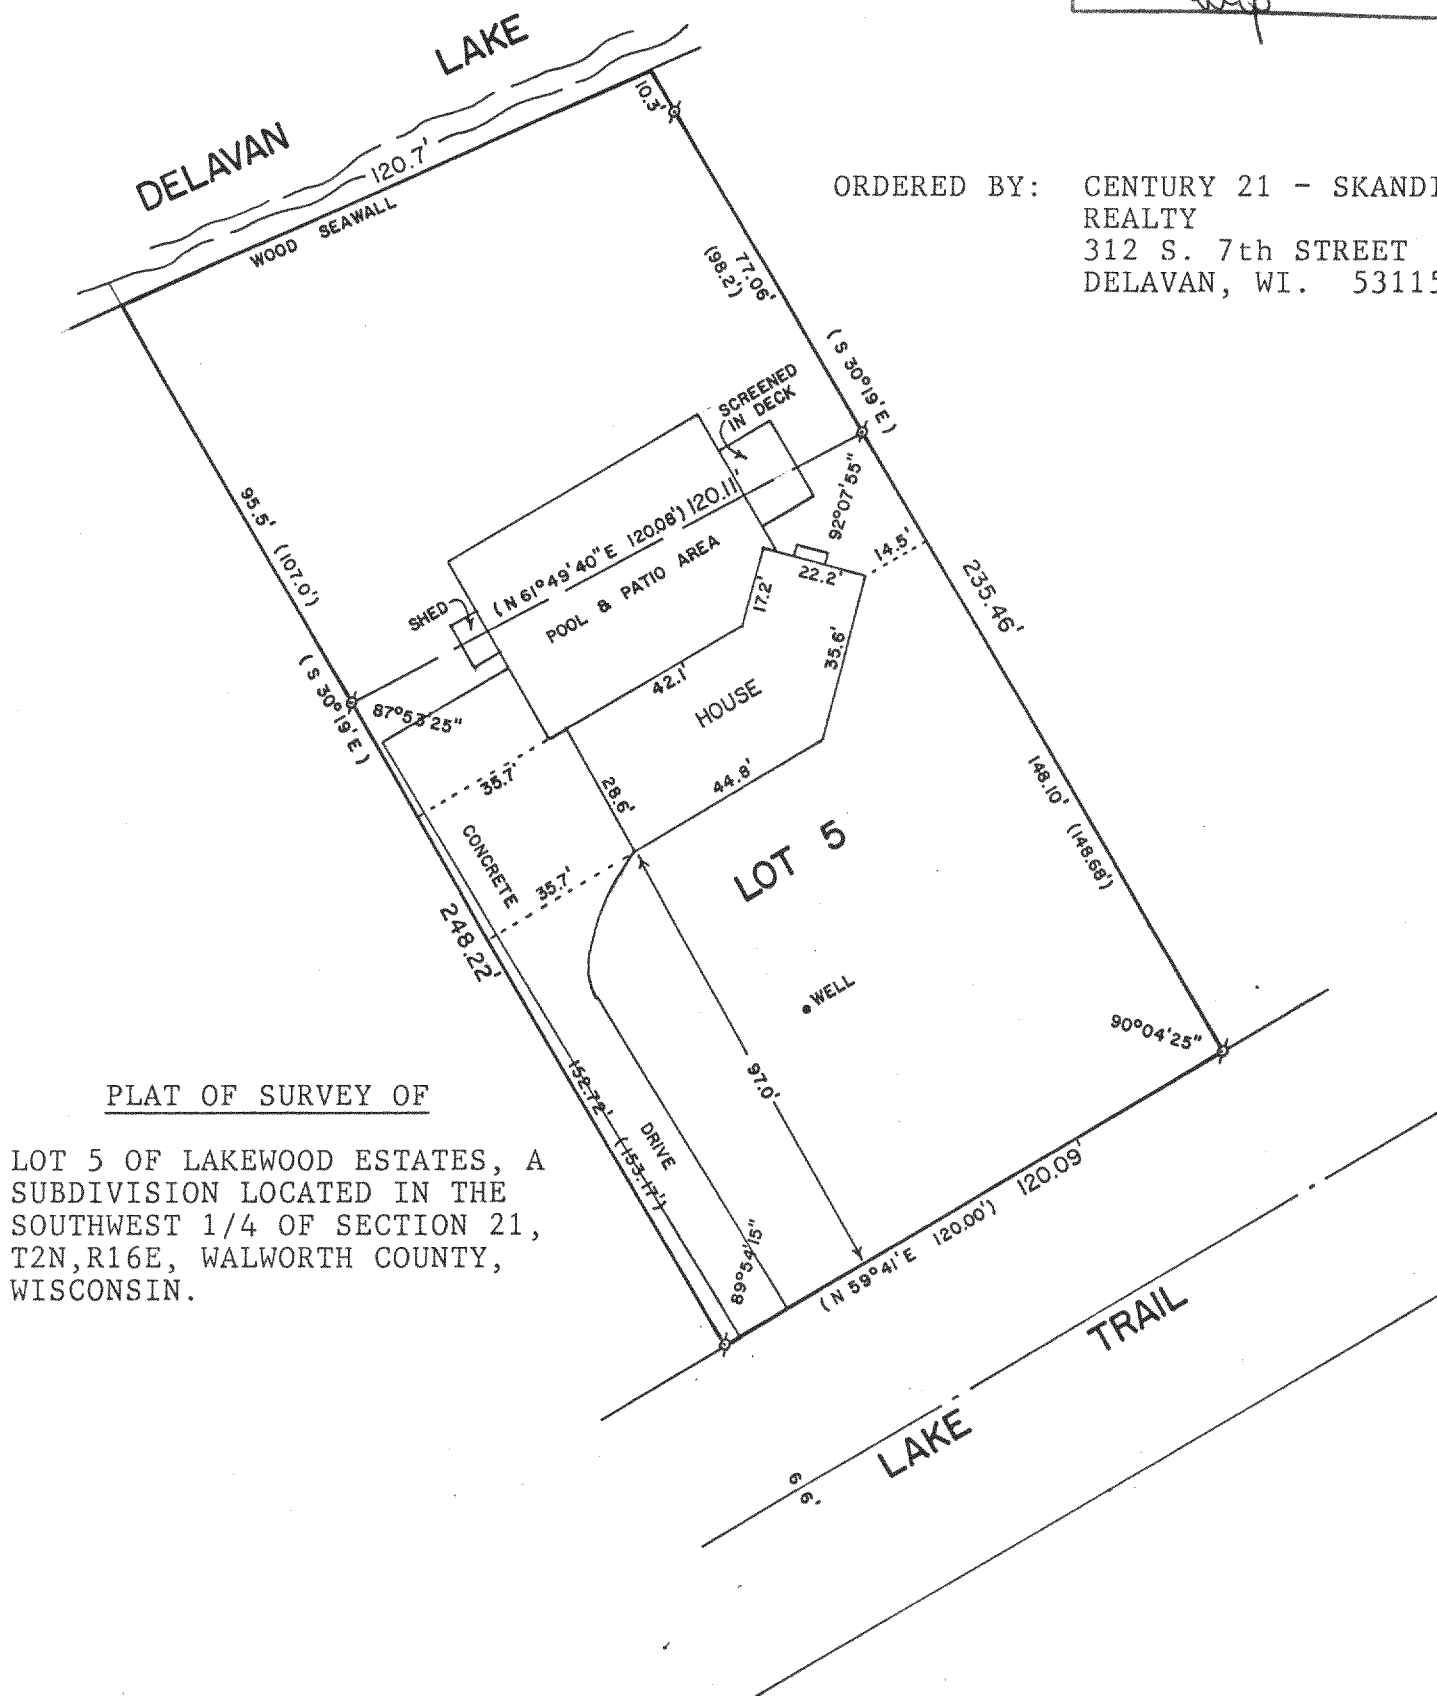

PLAT OF SURVEY OF

LOT 5 OF LAKEWOOD ESTATES, A
SUBDIVISION LOCATED IN THE
SOUTHWEST 1/4 OF SECTION 21,
T2N,R16E, WALWORTH COUNTY,
WISCONSIN.

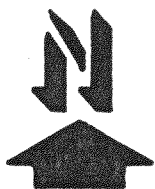

SCALE - 1"=40'

LEGEND

⊕ - IRON PIPE FOUND
() - RECORDED AS

I, DAVID F. ABELL, DO HEREBY CERTIFY
THAT I HAVE SURVEYED THE PROPERTY
HEREON DESCRIBED ACCORDING TO THE
OFFICIAL RECORDS AND THAT THE PLAT
HEREON IS A CORRECT REPRESENTATION
OF THE PROPERTY LINES TO THE BEST OF
MY KNOWLEDGE AND BELIEF.

David F. Abell

DAVID F. ABELL
WISCONSIN REGISTERED LAND SURVEYOR, S-1596

May 19, 1988

DATE JOB NUMBER - 88089

NOTE: THIS IS NOT A CERTIFIED COPY UNLESS SEALED.