


DUNHAM SURVEYING, S. C.
SURVEYING & SUBDIVIDING
DELAVER, WISCONSIN 53115

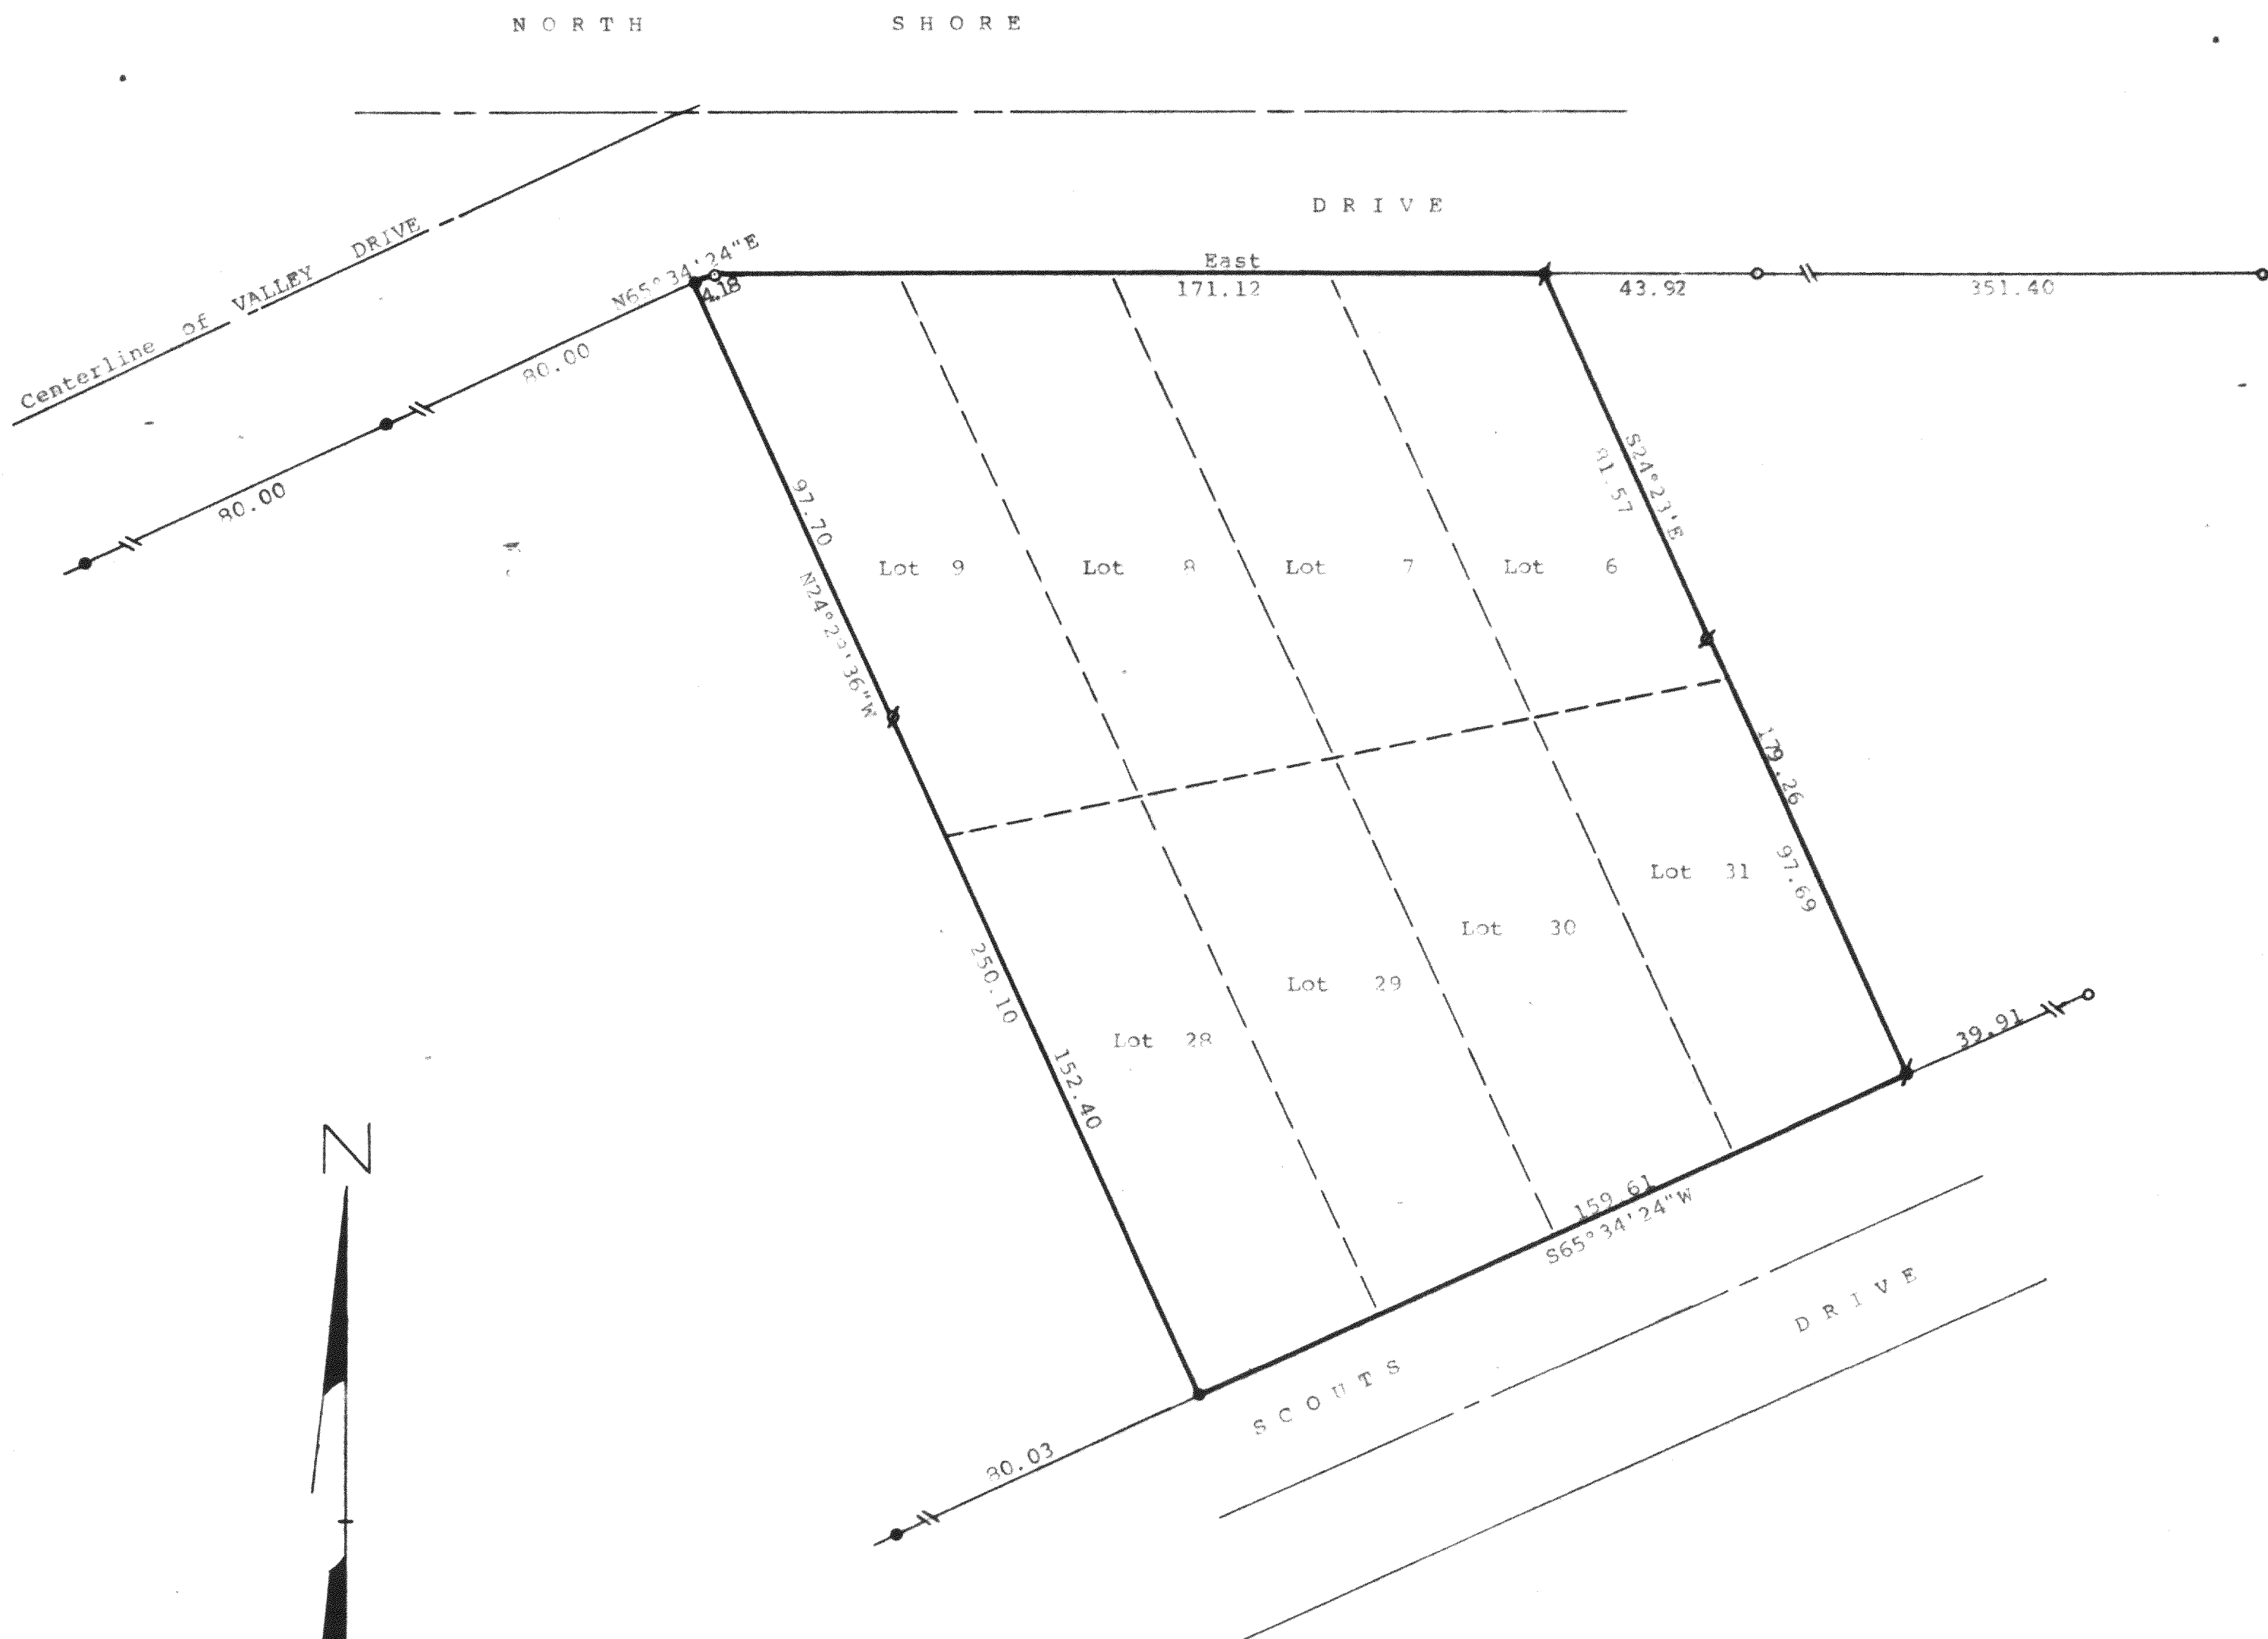

Scale - 1" = 30'

● = 1" Dia. Iron Pipe Found

○ = 3/4" Dia. Iron Pipe Found

✱ = 3/4"x24" Iron Pipe Set

✱ = 1/2"x24" Iron Pipe Set

Survey Ordered By:
Ron Deschner
Rt. 2
Shagbark Road
Whitewater, WI 53190

Bearings are referenced to the south line of North Shore Drive, assumed bearing of East.

STATE OF WISCONSIN) ss
COUNTY OF WALWORTH)

I, George T. Dunham, Surveyor, certify that I have surveyed the property described as follows,

Lots 6, 7, 8, 9, 28, 29, 30, and 31 in Block 6 of Delavan Lake View Crest, a subdivision located in Section 31, T2N, R16E, Walworth County, Wisconsin,

and that the map shown hereon is a correct representation thereof and shows the size and location of the property, its exterior boundaries, the location of all visible structures and dimensions of all principal buildings thereon, boundary fences, apparent easements, roadways and visible encroachments, if any, and that I have surveyed the property hereon described according to the official records, to the best of my knowledge and belief.
July 29, 1988.

George T. Dunham
George T. Dunham, Surveyor

