




○=IRON PIPE
SCALE ~ 1"=20'

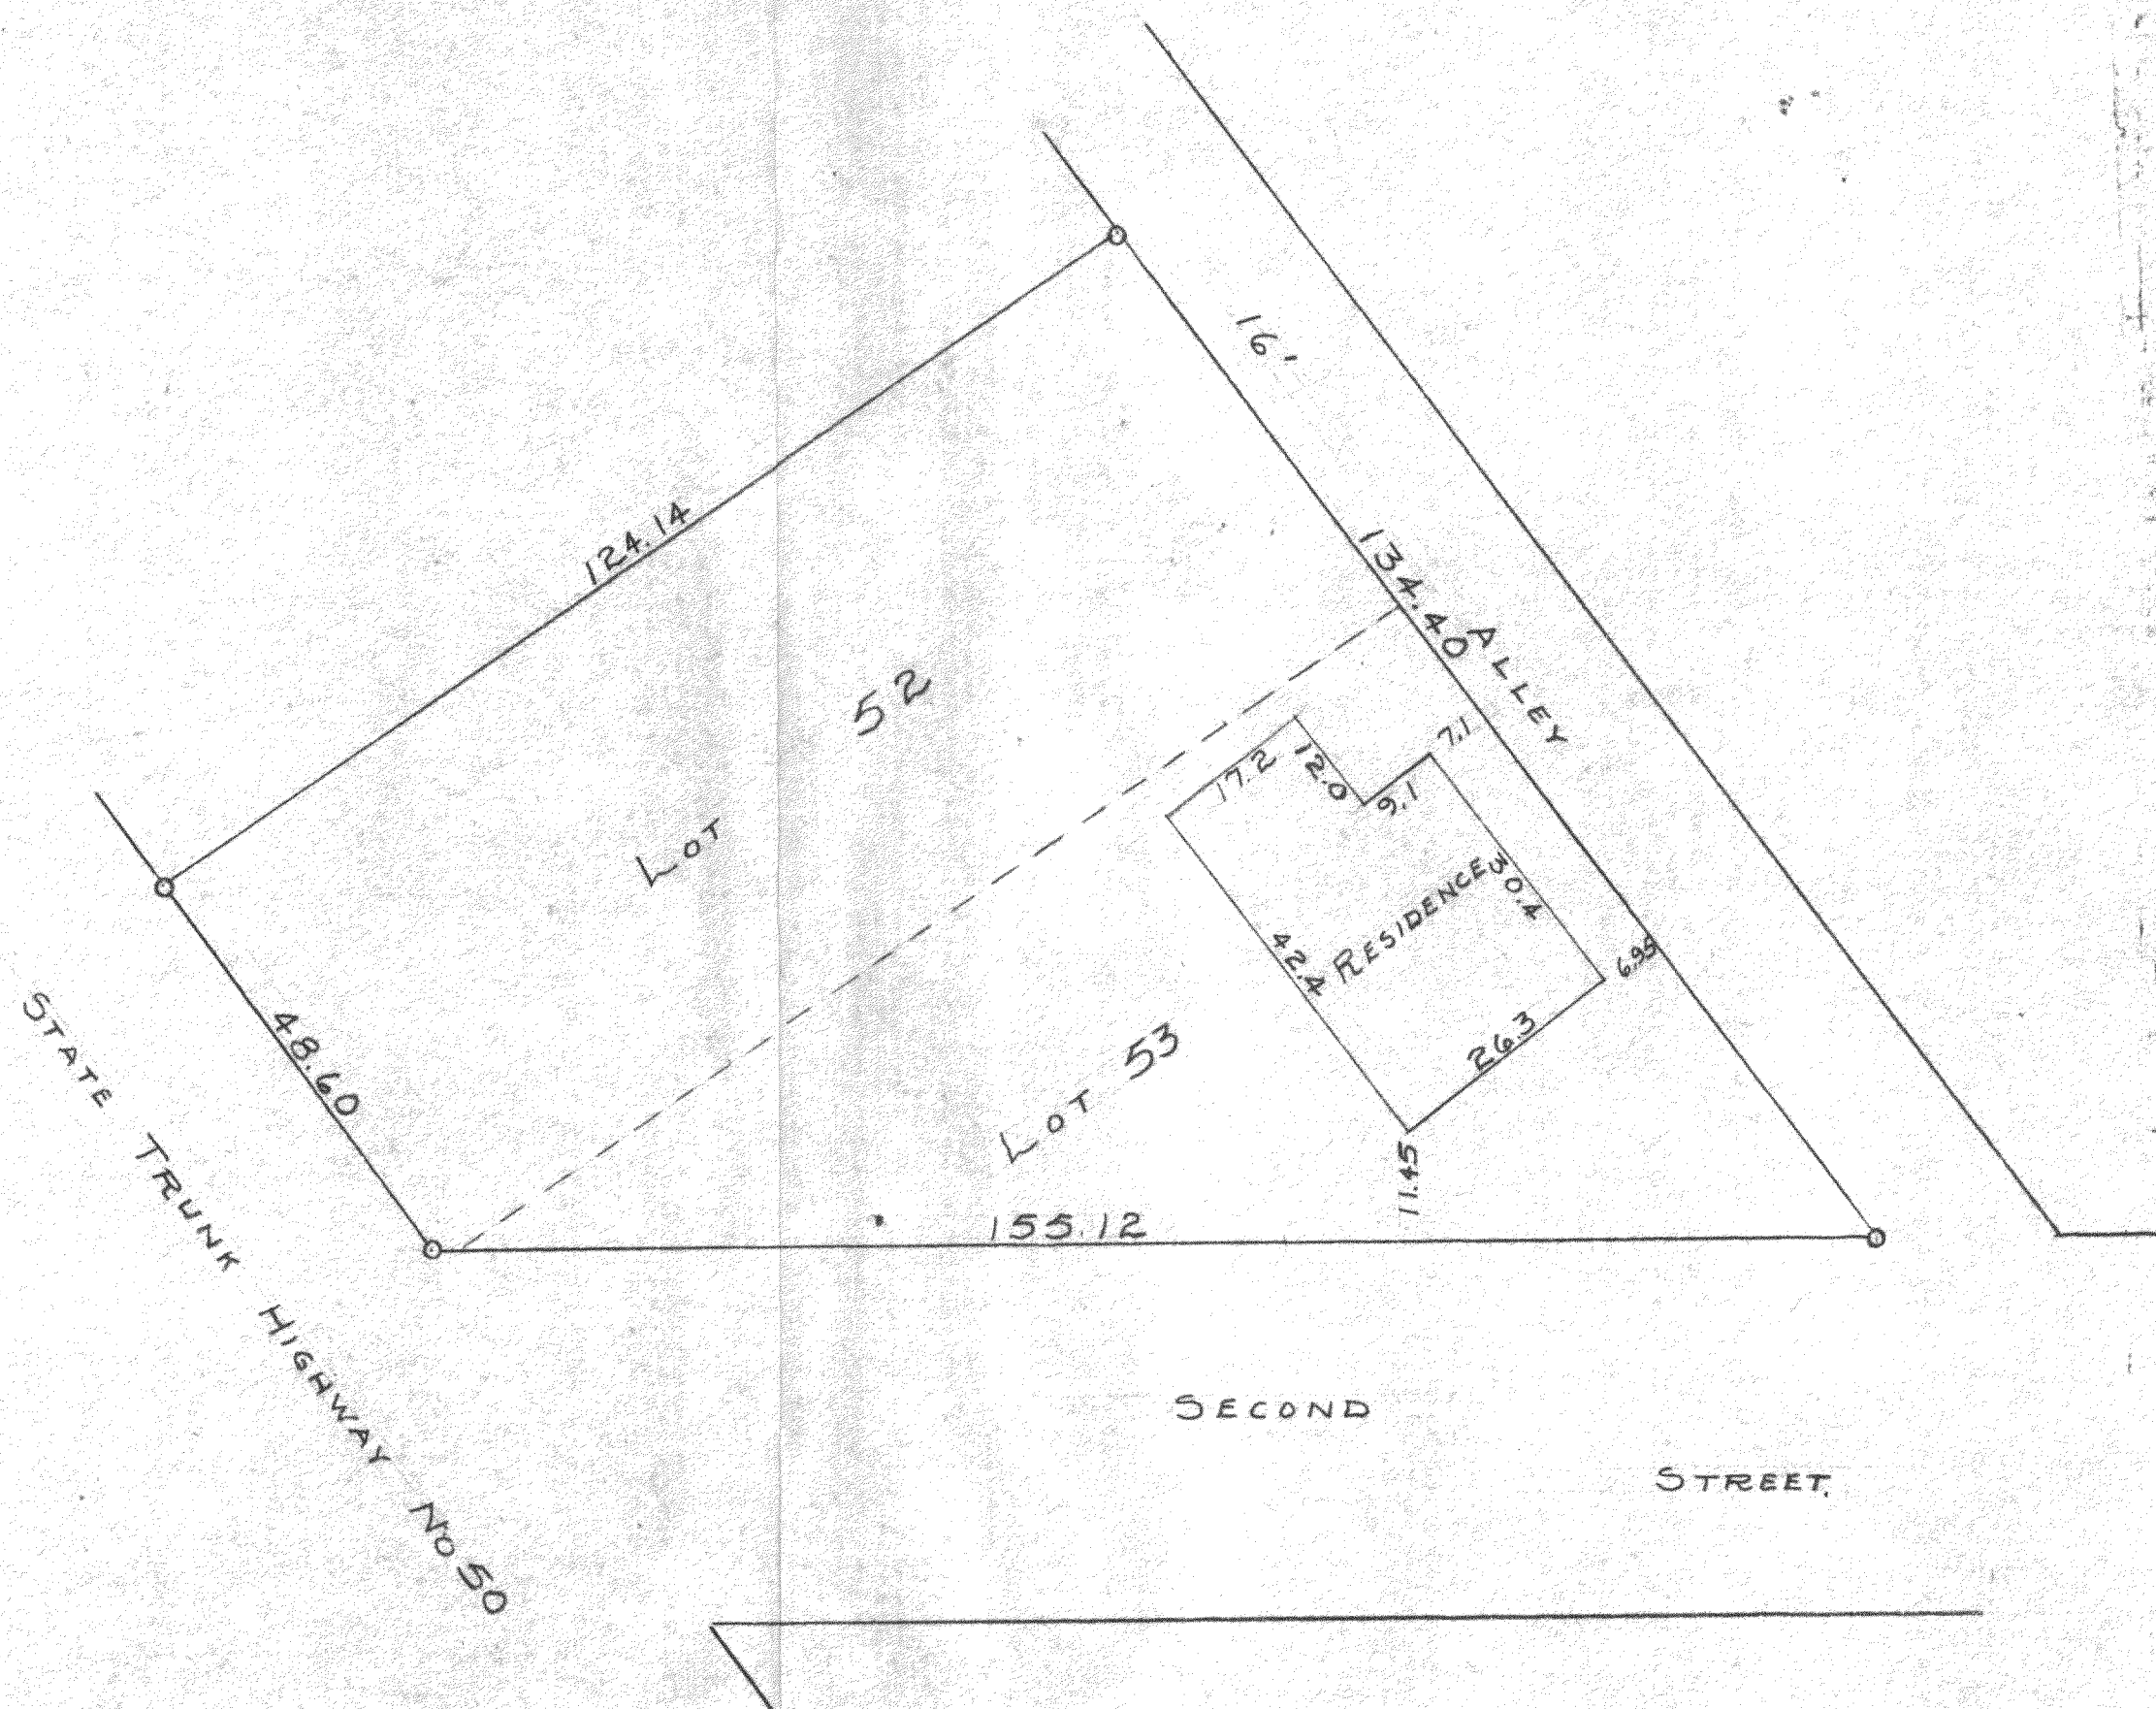

STATE OF WISCONSIN)
WALWORTH COUNTY)

I, GEORGE T. DUNHAM, DO HEREBY CERTIFY THAT I HAVE SURVEYED
THE PROPERTY DESCRIBED AS FOLLOWS:

LOTS 52 AND 53, BLOCK 3 OF INLET OAKS SUBDIVISION NO. 3
LOCATED IN SECTIONS 15 AND 22, T2N R1E OF WALWORTH COUNTY,
WISCONSIN.

AND THAT THE PLAT SHOWN ABOVE IS A CORRECT REPRESENTATION OF THE
PROPERTY LINES AND OF THE IMPROVEMENTS LOCATED THEREON.

DEC. 3, 1959

George T. Dunham
GEORGE T. DUNHAM
WIS. LAND SURVEYOR NO. S-306
DELAVER, WISCONSIN

216-108